


Section 30 Township 27 Range 13 W

Well No. # 1 Apt.

Company W. J. Coppinger

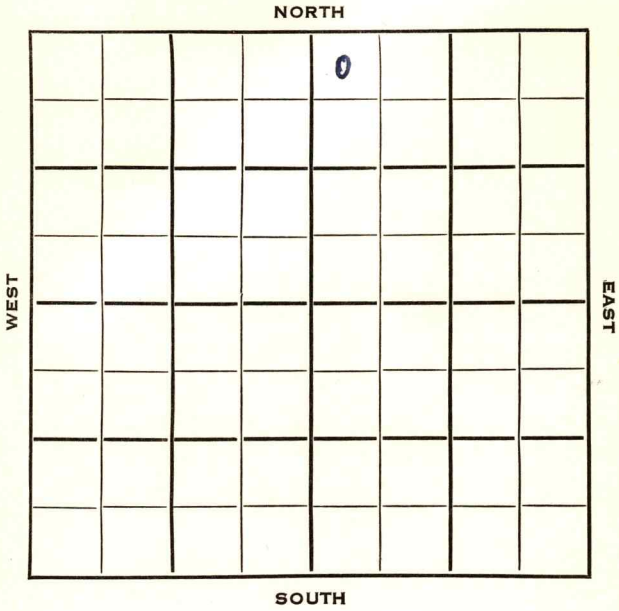

Sec. 30 Twp. 27 R. 13W

Well No. #1 Apt. Farm _____

W.J. Coppinger Company _____


Contractor _____

330 Ft. from N. Line

_____ Ft. from S. Line

_____ Ft. from E. Line

330 Ft. from W. Line

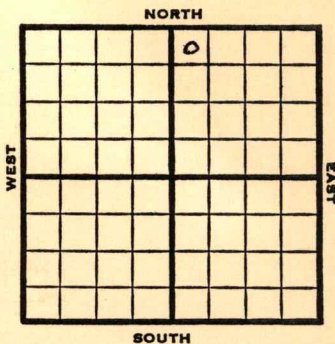

NW NW NE
Texas Support

1953 **Elev. 1930'** REPORT

7/1 Loc.

7/8 8" @ 400
Drlg. 2200'

7/22 **KC 3840**
DST 3865-3880 1 hr, 90' ocm 70#
DST 4057-66, 1 hr, 20' OCM, 495#
DST 4068-81 1 hr, 210' fluid, Cong
4266, Miss 4273, Kh 4299, V. 4326
Drlg.

7/29 **Simp 4415'**
DST 4412-30, 1½ hrs, 40' WCM 1430#
RTD 4455 5" @ 4142 CO 4105'

8/5 12/ 4077-80 700 A S/ 11½ BO / 3½
bwph 5 hrs.

8/12 N.R.

8/26 NR

9/9 Spud 7-2-53

Oil Well
TD 4455'
8" @ 400'

KC 3840'
DST 3865'-3880 opn 1 hr, rec 90' ocm,
70#

OVER

1953

Information brought forward.

9/9

DST 4057-66 opn 1 hr, rec 20' ocm
495#.

DST 4068-81 opn 1 hr, rec 210' fluid
Cong 4266, Miss 4273, Kh. 4299,
Viola 4326, Simp 4415,

DST 4412-30 opn 1½ hr, rec 40' wcm
1430#

TD 4455'

5" @ 4142'

CO to 4105'

12/ 4077-80 700 A S/ 11½ bo 3½
bwph

Comp. 216 bopd. 10% wtr.

COMPLETED

