


Section 30 Township 27 Range 13W

Well No. #2 Apt

Company Coopinger

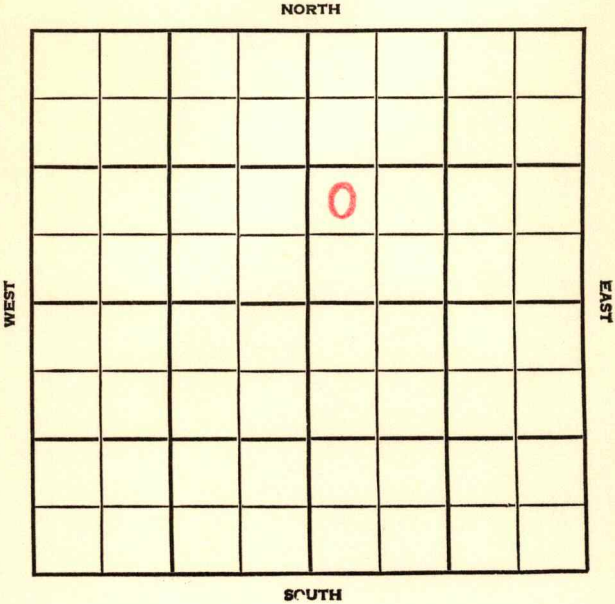

Pratt

KANSAS

SEC.	TWP.	R.
30	27	13W

WELL NO.

2 Apt

FARM

COMPANY

Coopinger

CONTRACTOR

Co. Tools

Fitzsimmons Pool

Ft. from N. Line

990'


Ft. from S. Line

Ft. from E. Line

330'

Ft. from W. Line

NW SW NE

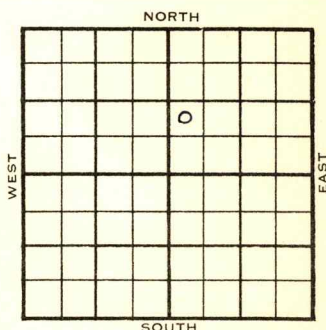

1955

ELEVATION

1925

REPORT

5/25

RUR

7/20

Comm 5-24-55

8 5/8" @402/250 Dst 3859-75, open 1 hr gas in 15 min. Rec. 60' hocm, 180' mud dy oil 120' oil 60' wtr. 1225/20" DST 4050-60 open 1 hr. Rec 45' vsocm 115/20" DS 4062-81 open 1 hr. gas in 4 1/2 min. 139 mcfg Rec. 360' gcmo 1040' free oil 993# DS 4212-30 open 1 hr. Rec. 90' mud 325/30" DST 4252-60 open 1 hr. Rec. 40' mud 1007# 5 1/2" @4180 CO to 4145 PBTD 20/4067-72 B/1 1/2 bo 1 1/2 hr. 350 A F/35 boph 12 hr. Comp. 326 bopd.

Tops

Depth

Datum

Anh.

822

KC

3830

1905

BKC

4164

2239

C.

4232

2307

M.

4250

2325

K.

4310

2385

V.

4333

2408

TD.

4347

COMPLETED

County Pratt Elev. 1925
 Sec. 30 Twp. 27 Rge. 13W
 Company Coppinger
 Farm Name Apt No. 2

TOPS	DEPTH	LOG	DATUM	Loc. in Sec.
Anh.	<u>822</u>			NW SW NE
TP.				
H.				
Tr.				
Dg.				
BL.				
L.				
K.C.	<u>3830</u>		<u>1905</u>	Geol.
B.K.C.	<u>4164</u>		<u>2239</u>	Contr.
Ce.				
C.	<u>4232</u>		<u>2307</u>	Co. tools
M.	<u>4250</u>		<u>2325</u>	
M.				
K.	<u>4310</u>		<u>2385</u>	Pool
Mz.				Fitzsimmons
Mq.				
V.	<u>4333</u>		<u>2408</u>	
S.				
S.				
A.				
R.				
PE.				
G.				
T.D.	<u>4347</u>			



Date Comm. 5-24-55 JUL 20 1955
8 5/8" @ 402/250 DST 3859-75 open 1 hr.
 gas in 15 min. Rec. 60' hocm 180' muddy
 oil 120' oil 60' wtr. 1225/20"
 DST 4050-60 open 1 hr. Rec. 45' vsocm
 115/20" DST 4062-81 open 1 hr.
 gas in $4\frac{1}{2}$ min. 139 mcfg Rec. 360' gcmo
 1040' free oil 993# DST 4212-30
 open 1 hr. Rec. 90' mud 325/30"

OVER

DST 4252-60 open 1 hr. Rec. 40' mud
1007# 5 $\frac{1}{2}$ " @ 4180 CO to 4145 PBTB
20/ 4067-72 B/ 1 $\frac{1}{2}$ bo 1 $\frac{1}{2}$ hr. 350 A
F/ 35 boph 12 hr. Comp. 326 bopd

Scout Cards	_____
Land Small Map	_____
Land Wall Map	_____
Tracings	_____
France Map	_____
Pierce Map	_____
Misc.	_____

[Handwritten signature]

JUL 27 1955

County Pratt State KansasSec. 30 (Blk. Twp.) 27 (Sur. Rge.) 13W Map No.Operator CoopingerWell No. 2 Farm AptElev. Location NW SW NE990 Ft. From S Line NE330 Ft. From W Line Quarter1st. Report MAY 25 1955

Completion

Remarks

Co. tools

Spudding Date

Drlg. Data Fitzsimmons PoolRURK-26