


Section 30 Township 27 Range 13W

Well No. 1 Fitzsimmons

Company W. J. Coppinger

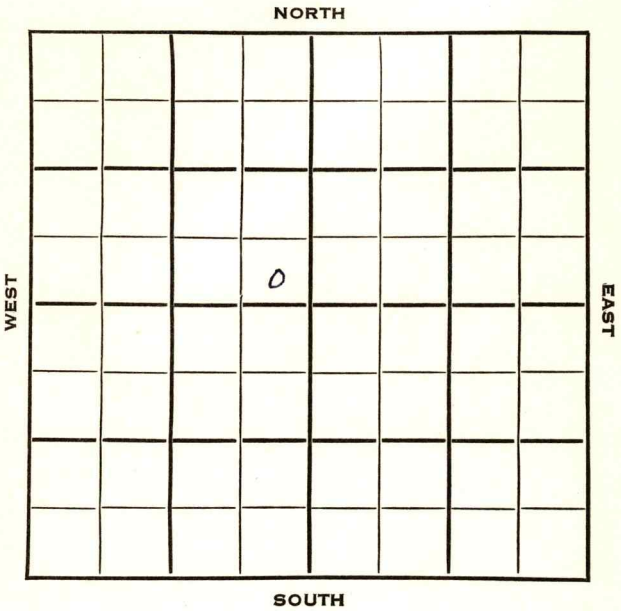


Pratt

KANSAS

Sec. 30 Twp. 27 R. 13WWell No. 1 Fitzsimmons FarmW. J. Coppinger CompanyCoppinger - Contr. ContractorWildcat Ft. from N. Line330 Ft. from S. Line330 Ft. from E. Line Ft. from W. Line

SE SE NW

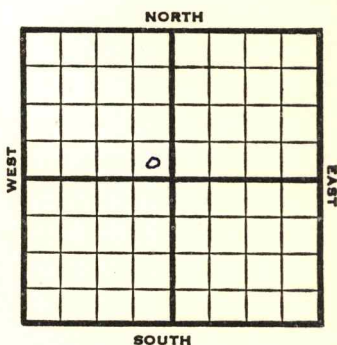

1953

Elev. 1925'

REPORT

1/7

Spudding Date 1/4/53
Set Surface WOC

1/22

Heeb 3668, Br 1i 3815, Lans
3835DST 4053-75, 1 hr., 1206' free
oil, 1470#

Miss 4262

DST 4260-70, 1 hr., 20' M

KH 4294

Dflg. 4308'

1/29

V 4320'

DST 4320-48, 1 hr, 1090' gas, 75' I
VSOCM 500#

DST 4364-4400 1 hr, 40' M 750#

Simp sd 4406' Arb 4502'

RTD 4561 5" @ 4430'

2/5

CO 4409

48/4322-30, 3000A

B/ 3 goph + SG

PB 4251, st-lift S/18 BW + 11½ BO
70 hrs.PB 4132, 22/4068-71, F/ 20 BO
4 hrs. G 36PB 4063, 24/4056-60, SO 500A
est F 25 BOPH

2/12

NR

OVER

1953
2/18

Spud 1-4-53

Oil well TD 4561' 8" @ 379

Anhy 815' Heeb 3668' Br. li 3815

Lans. 3835'

DST 4053-75 open 1 hr. rec 1200' free
oil 1470# Miss 4262'

DST 4260-70 open 1 hr. rec 20' mud

Kh. 4294' Viola 4320'

DST 4320-48 open 1 hr. rec 1090' gas
75' VSOCM, 500#

DST 4364-4400 open 1 hr. rec 40' mud
750# Simp. 4406' Arb. 4502'

TD 4561' 5" @ 4445 CO to 4409

48/4322-30 3000 A B/3 GOPH

PB 4251 st-lift S/18 BW 11½ BO

10 hr. PB 4132 22/4068-71

F/20 BO 4 hr. PB 4063 24/4056-60

SO 500 A F/25 BOPH

Comp. 1052BOPD

COMPLETED


COMPLETE

J. G. McGEHEE

