


**KANSAS** Pratt

FORM 51 5M 11-44 PETROL

Section 30 Township 27 Range 13-W

Well No. #1 Shanley


Company Hubert Hatfield

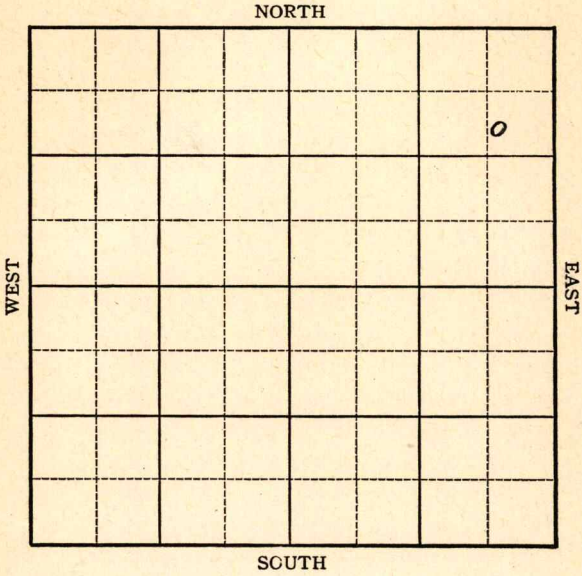

Sec. 30 Twp. 27 R. 13-W

Well No. #1 Shanley Farm  
Hubert Hatfield Company

990 Ft. from N. Line  
         Ft. from S. Line  
530 Ft. from E. Line  
         Ft. from W. Line

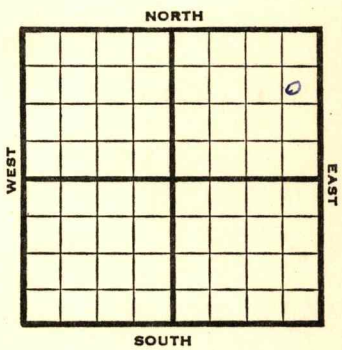

C S L N E N E

1945

**Elev. 1938'**

R E P O R T

12/5

RUR

12/12

Drlg. 345

12/20

10" - 402' Anhy 670' Drlg. 2760'

12/29

Topeka 3348' Lans 3858'  
Sat 4009-11' T.D. 4019'

1946

1/10

Miss 4264' Viola 4343'  
Simp Sand 4427' Arb. 4534'  
T.D. 4536' 5" - 4535' RUST.

1/17

TD 4585' 800' water in 2 hrs.  
P.B. to 4430'

1/24

Plug 4072' 12 shots 4052-56'  
4000 acid. Swab 26 oil & 170 water in  
10 hours.

1/31

24 shots 4006-14' 12 shots 4002 to 4006  
11 shots 4011-15' 24 shots 3875-83 SW  
24 shots 3886-94'  
Shut down.

2/6

**Arb. 4534**  
5" @ 4535  
TD 4585'

**ABANDONED**



**KANSAS** Kansas Pool Name Wildcat

Map No. 92 Sec. 30 Twp. 27 R. 13W

Well No. 1 Shanley

Huber & Hatfield Company

**ABANDONED**

Contractor

C S L NE NE

*E 1, 1938*  
**SECTION PLAT**

			0

990 Ft. from N. Line

\_\_\_\_\_ Ft. from S. Line

530 Ft. from E. Line

\_\_\_\_\_ Ft. from W. Line

Pratt County

Location \_\_\_\_\_

Rig up \_\_\_\_\_

Drilling and Remarks:

*CU 4534*

*5' 10 4585*

**RECORD**

Cased \_\_\_\_\_ in., \_\_\_\_\_ ft.

Sand \_\_\_\_\_

Gas \_\_\_\_\_

Oil \_\_\_\_\_

Total Depth 4585

**PRODUCTION**

1st 24 hrs. Nat. \_\_\_\_\_

1st 24 hrs. after shot \_\_\_\_\_

Gas \_\_\_\_\_ Cu. Ft.

Dry Hole \_\_\_\_\_

Abandoned \_\_\_\_\_

Date

FEB 6 1946

19

S. J. LEWIS Scout