


Section 1 Township 27 Range 13-W

Well No. #1 Calbeck

Tuesday Oil
Company ~~Hannum Drilling et al~~

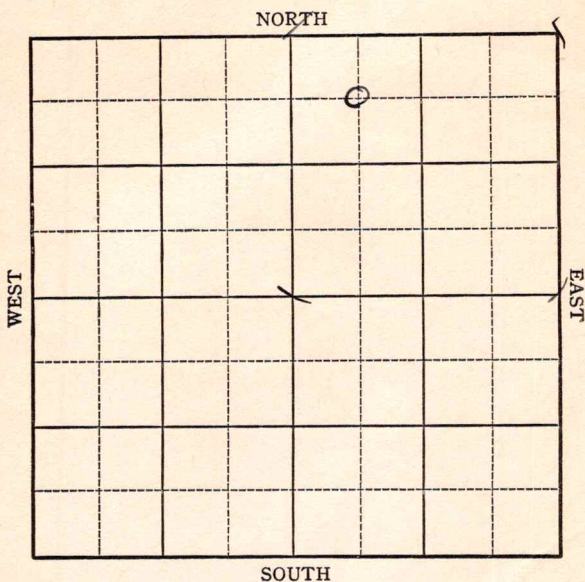

KANSAS

Iratt

Sec. 1 Twp. 27 R. 13-W

Well No. #1 Calbeck Farm

Hannum Drilling et al Tuesday Oil Company

(Semi Wildcat)


660 Ft. from N. Line

 Ft. from S. Line

 Ft. from E. Line

660 Ft. from W. Line

Elev. 1908

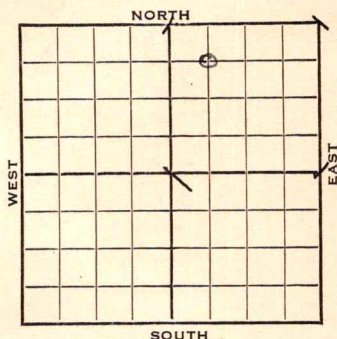

1942

REPORT

7/22	Bldg. Derrick
7/29	Derrick
8/5	"
8/12	Spud SD
8/19	" "
8/27	" "
9/2	" "
9/9	" "
9/16	10" @ 432 Drlg 975
9/23	Drilling 2470'
9/30	Drlg. 3878'
10/7	Viola 4145 Simp. sh 4210 Simp sd 4214 T.D. 4217 fsg.
10/14	" "
10/21	" " "
10/28	" 2 "
11/4	7" @ 4223 TD 4227 Rust
11/11	TD 4229' SS0 4 qts. 4223-29 CO
11/18	TD 4232 - 1000 acid Swb 2 oil per hr

OVER

1942

11/24 2500 acid estimate
10 oil a day
TD 4287 fsg.

12/2 Arb 4327
122' arp 5" anier @ 4320
TD 4347 - 1000 acid swb
120 wtr. in 12 hrs.

12/9 " " "

12/16 Arb. 4327
7" @ 4223
T.D. 4347'
122' of 5" liner 4320.
Water.

4327
1905
2419

ABANDONED

KANSAS

Pratt

Map No. 92 Sec. 1 Twp. 27 R. 13WWell No. 1 CalbeckHannum Drilling et al. CompanyFIRST REPORT

Contractor

C NW NE


660 Ft. from N. Line

Ft. from S. Line

Ft. from E. Line

660 Ft. from W. Line

SECTION PLAT

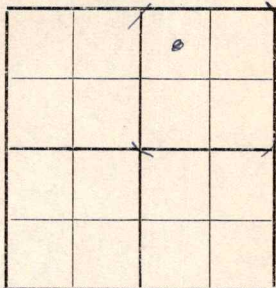

SEMI WILDCAT

Location _____

Rig up _____

Drilling and Remarks:

Bldg. Derrick

RECORD

Cased _____ in., _____ ft.

Sand _____

Gas _____

Oil _____

Total Depth _____

PRODUCTION

1st 24 hrs. Nat. _____

1st 24 hrs. after shot _____

Gas _____ Cu. Ft.

Dry Hole _____

Abandoned _____

Date

JUL 22 1942


19

S. J. LEWIS Scout

Map No. 92 Sec. 1 Twp. 27 R. 13WWell No. 1 CalbeckTuesday Oil CompanyCORRECTION Contractor

C NW NE

SECTION PLAT

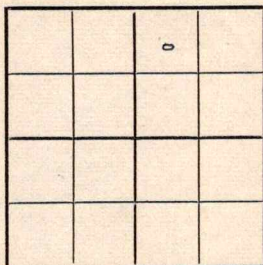660 Ft. from N. Line Ft. from S. Line Ft. from E. Line660 Ft. from W. Line

SEMI-WILDCAT

Location Rig up

Drilling and Remarks:

Reported as

Hannum Drlg.
etal.

RECORD

Cased in., ft.Sand Gas Oil Total Depth

PRODUCTION

1st 24 hrs. Nat. 1st 24 hrs. after shot Gas Cu. Ft.Dry Hole Abandoned

Date

00T 1 4 1942 19S. J. LEWIS Scout

Pratt

KANSAS
 Map No. 12 Sec. 1 Twp. 27 R. 13W

Well No. 1 Calbeck

Tuesday Oil et al.

Company

ABANDONED

Contractor


C NW NE

SECTION PLAT

660 Ft. from N. Line

Ft. from S. Line

Ft. from E. Line

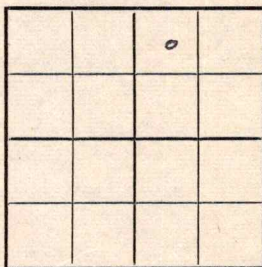660 Ft. from W. Line

SEMI-WILDCAT

Location

Rig up

Drilling and Remarks:

Ar 4327
7" CH 223
122' of 5 lines 4320
Water.

RECORD

Cased _____ in., _____ ft.

Sand _____

Gas _____

Oil _____

Total Depth 4347

PRODUCTION

1st 24 hrs. Nat. _____

1st 24 hrs. after shot _____

Gas _____ Cu. Ft.

Dry Hole _____

Abandoned _____

Date

DEC 16 1942 19

S. J. LEWIS

Scout