

KANSAS


Pratt

Form 51-5M-7-40-Palace

Section 1 Township 27 Range 13W

Well No. #1 Helmke

Company Skelly

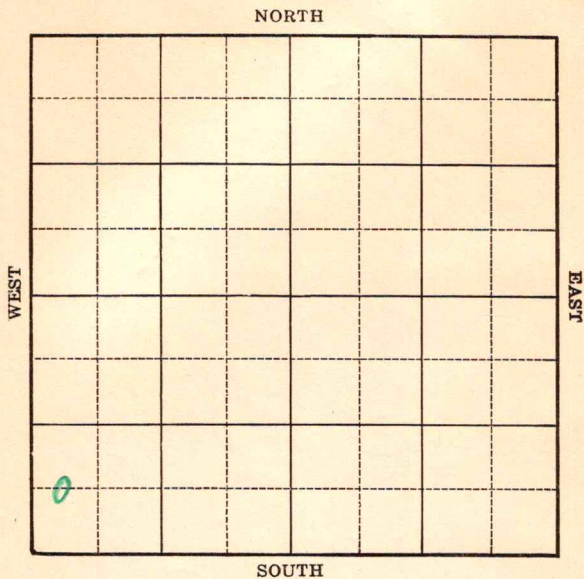


Sec. 1 Twp. 27 R. 13-WWell No. #1 Helmke FarmSkelly Company

(Cunningham)

 Ft. from N. Line660 Ft. from S. Line Ft. from E. Line330 Ft. from W. Line

Elev. 1905

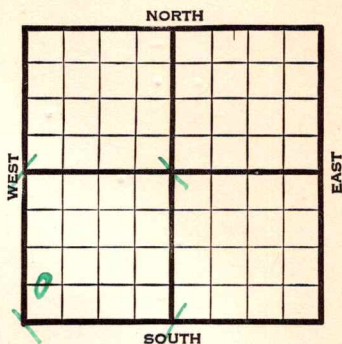

1940	REPORT
10/16	Location
10/24	Rotary.
10/31	10" - 398' Drlg. 1750'
11/7	Drlg. 3005'
11/14	Drlg. 3990'
11/21	Lans. 3736' Viola 4162'
	Simp. sh. 4239'
	Simp. Dolo. 4253' SO 4253-56'
	TD 4256' 7" - 4254' RUST.
11/27	" " " "
12/5	T.D. 4268' SD. 16-2/10 M gas.
	SSO.
12/12	Drlg. 4296'
12/19	TD 4353' SD.
12/26	Arb. 4353½-55' T.D.
	4" - 4355' RUST.
1941	
1/2	T.D. 4367' 1/4 bbl. oil per hr.
	OVER

1941
1/8

Simp. Dolo. 4253'

7" - 4254'

Arb. 4353 $\frac{1}{2}$ '

4" - 4355'

T.D. 4367'

1500 acid.

Echometer potential 5068 bbls
fluid.

Potential 1572 bbls. oil.

34.5 Gravity

COMPLETED

Map No. 92 Sec. 1 Twp. 27 R. 13WWell No. 1 HelmkeSkelly

Company

Contractor

FIRST REPORT

C W L SW SW

Ft. from N. Line


660 Ft. from S. Line

Ft. from E. Line

330 Ft. from W. Line

CUNNINGHAM POOL

SECTION PLAT

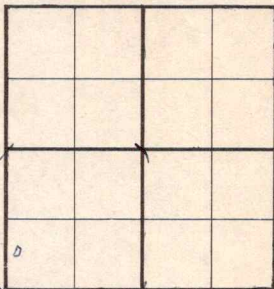Location X

Rig up

Drilling and Remarks:

RECORD

Cased _____ in., _____ ft.

Sand _____

Gas _____

Oil _____

Total Depth _____

PRODUCTION

1st 24 hrs. Nat. _____

1st 24 hrs. after shot _____

Gas _____ Cu. Ft.

Dry Hole _____

Abandoned _____

Date

OCT 16 1940 19S. J. LEWIS

Scout

Map No. 92 Sec. 1 Twp. 27 R. 13WWell No. 1 HelmkeSkelly Oil

Company

Contractor

COMPLETED

C W L SW SW

Ft. from N. Line

660 Ft. from S. Line

Ft. from E. Line

330 Ft. from W. Line

CUNNINGHAM POOL

SECTION PLAT

10			

Location

Rig up

Drilling and Remarks:

*Strip Hole 4253**7" @ 425-4**Ar 8 435 3 1/2**4" @ 435 5.**1500 acid**Ech & P 45068 Fluid**P 4-15-72 oil**34.5 Gr.*

RECORD

Cased _____ in., _____ ft.

Sand _____

Gas _____

Oil _____

Total Depth 4367

PRODUCTION

1st 24 hrs. Nat. _____

1st 24 hrs. after shot _____

Gas _____ Cu. Ft.

Dry Hole _____

Abandoned _____

Date

JAN 8 1941 19

S. J. LEWIS Scout