


Section 1 Township 27 Range 13W


Well No. #1 Helmke

Company Bob Lindsley

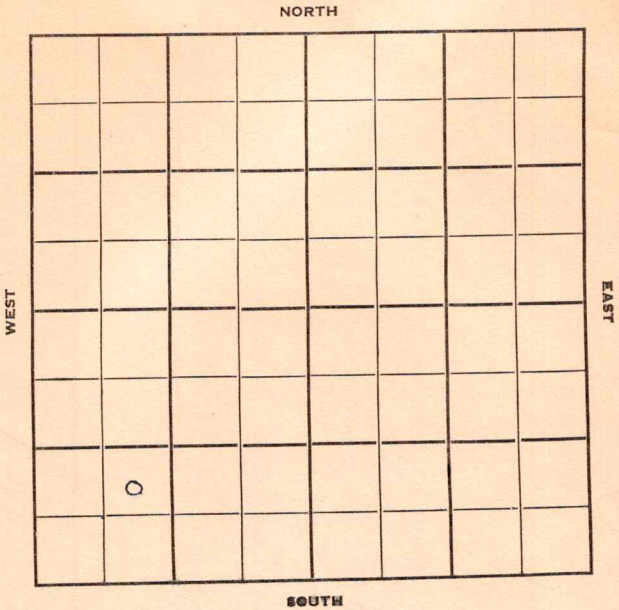

Sec. 1 Twp. 27 R. 13WWell No. #1 Helmke FarmBob Lindsley CompanyLindsley - Contr. ContractorTuka Pool Ft. from N. Line990' Ft. from S. Line Ft. from E. Line990' Ft. from W. Line

NE SW SW

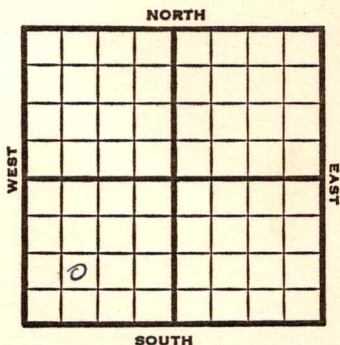

1951

Elev. 1894' REPORT

8/15

Spud 8-10-51

8" @ 264

Drlg. 1524

9/5

Spud 8-10-51

D&A TD 4399

8" @ 264

KC 3725 Miss. 4077 Kh. 4118

Viola 4142

DST 4152-77 open $\frac{1}{2}$ hr. rec. 15' GCM

Simp. 4226

DST 4238-56 open $\frac{1}{2}$ hr. rec. 600' gas
40' GCMDST 4262-86 open 1 hr. gas in 33 min.
rec. 300' SW 15' GCM

Arb. 4338

DST 4351-81 open 45 min rec. 3100'

sulphur wtr. TD 4399

D&A

ABANDONED

County Pratt State Kansas
Sec. 1 (Blk.) 27 (Sur.) 13W Map No.
Operator Bob Lindsley
Well No. 1 Farm Helmke
Elev. Location NE SW SW



990 Ft. From S Line SW
990 Ft. From W Line Quarter

1st. Report AUG 15 1951

Completion

Remarks


Lindsley - Contr.

Spudding Date 8-10-51

Drlg. Data

Iuka Pool

8" @ 264 drlg. 1524

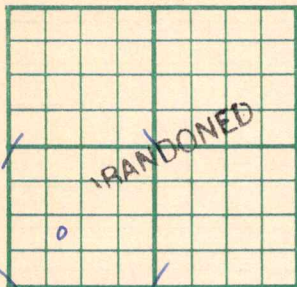County Pratt State KansasSec. 1 (Blk.) 27 (Sur.) 13W Map No.Operator Bob LindsleyWell No. 1 Farm HelmkeElev. 1894 Location NE SW SW990 Ft. From S Line SW990 Ft. From W Line Quarter

1st. Report

Completion SEP 5 1951Remarks Iuka PoolLindsley - Contr.Spudding Date 8-10-51Drig. Data D & A TD 43998" @ 264 KC 3725 Miss. 4077Kh. 4118 Viola 4142 DST 4152-77open $\frac{1}{2}$ hr. Rec. 15' gcm Simp. 4226DST 4238-56 open $\frac{1}{2}$ hr. Rec. 600' gas40' gcm DST 4262-86 open 1 hr. gas in 33 minRec. 300' sw 15' gcm Arb. 4338DST 4351-81 open 45 min. Rec. 3100'sulphur water TD 4399D & A