

Section 1 Township 27 Range 13W

Well No. #1 Calbeck "A"

Company C. R. A. & Beardmore

O.W.W.O.

NORTH

WEST

EAST

							0

SOUTH

Pratt
27

KANSAS

Sec. 1 Twp. 27 R. 13W

Well No. #1 Calbeck "A" Farm

C.R.A. & Beardmore Company

Beardmore-Contr. Contractor


O.W.W.O.

990' Ft. from N. Line

Ft. from S. Line

330' Ft. from E. Line

Ft. from W. Line

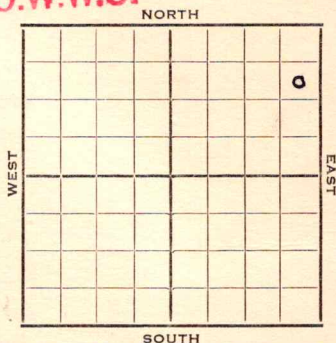

SE NE NE

1952

Elev. 1909'

REPORT

1/30

RUR

2/6

Drlg. 2865'

2/13

Heeb. 3466 Br Li 3698 Lans. 3712

DST 3817-37 1 hr. 135' SW

DST 3913-30 1 hr. 60 O&GCM 1060#

B P Miss 4088

DST 4088-4121 1 hr. 2420' gas

90' O&GCM 400# BHP KH 4121

Viola 4146 Drlg. 4166

2/20

Simp Shale 4214 Simp sd 4242

Arb. 4314

TD 4321

5" @ 4317'

3/4

S/9½ BO 1st hr. S/8¼ BO 5th hr.

POP

3/12

"

3/19

NR

3/25

NR P/72 BO & 105 BW 24 hrs.

4/1

NR

OVER

1952

4/9 Spud 1-31-52
Oil Well TD 4343
8" @ 465 Heeb. 3466
Br lime 3698 Lams 3712
DST 3817-37 opn 1 hr. Rec. 135' sw
DST 3913-30 opn 1 hr. Rec. 60'
o & gcm Miss 4085
DST 4088-4121 opn 1 hr. Rec. 2420'
gas 90' o & gcm Kh 4121 Viola 4138
Simp sh 4212 Simps sd 4237
Arb. 4324 TD 4321
5" @ 4317 CO 4343 PB 4310
66/4240-51 VSSO Hydra
S/9½ bo 1 hr. 8¼ bo 5 hr.
Comp. 27 bopd 28% wtr.

COMPLETED

O.W.W.O.

1952

7/30 Viola 4138 Simp 4237
Arb. 4324
5" @ 4317 OTD 4343
SP 4214 16/4189-93 38/4186-94
44/4167-78 A-frac
S/22 bo 14 bw 14 hrs.
8/6 "
8/13 PB 4121 86/4087-4106 SSO
A frac P/24-3/4 BO & 29 Bwpd
Drove plug 4298 P/47 BO & 70%
wtr. 24 hrs.
8/20 NR
8/27 Oil Well TD 4343
Viola 4138 Simp 4237 Arb. 4324
5" @ 4317 OTD 4343 SP 4214
16/4189-93 38/4186-94
44/4167-78 A-frac S/22 bo
14 bw 14 hr. PB 4121 86/4087-4106
SSO A-frac P/24 3/4 bo 29 bwpd
DP 4298 P/47 bo 70% wtr.
Comp. 27 bopd 31 bw


COMPLETED

County Pratt State Kansas
 Sec. 1 (Blk. Twp.) 27 (Sur. Rge.) 13W Map No.

Operator CRA & Beardmore

Well No. 1 Farm Calbeck

Elev. 1909 Location SE NE NE

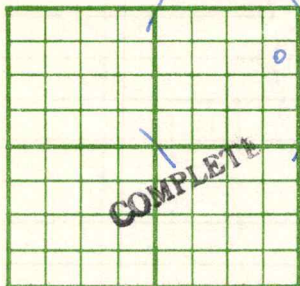

990 Ft. From N Line NE

330 Ft. From E Line Quarter

1st. Report

Completion APR 9 1952

Remarks

Beardmore - Contr.

Spudding Date 1-31-52

Drlg. Data Oil well TD 4343

8" @ 465 Heeb. 3466 Br. lime 3698

Lans. 3712 DST 3817-37 open 1 hr.

Rec. 135' sw DST 3913-30 open 1 hr.

Rec. 60' o & gcm Miss. 4085 DST 4088-

4121 open 1 hr. Rec. 2420' gas

90' o & gcm Kh. 4121 Viola 4138

Simp. sh. 4212 Simp. sd. 4237

Arb. 4324 TD 4321 5" @ 4317 CO 4343

PB 4310 66/ 4240-51 VSSO Hydro.

S/ 9½ bo 1 hr. 8½ bo 5 hr.

Comp. 27 bopd 28% water

County **Pratt** State **Kansas**Sec. **1** (Blk. Twp.) **27** (Sur. Rge.) **13W** Map No.Operator **C. R. A. & Beardmore**Well No. **1** Farm **Calbeck**Elev. Location **SE NE NE**

990 Ft. From **N** Line **NE****330** Ft. From **E** Line Quarter1st. Report **JAN 30 1952**

Completion

Remarks


Beardmore - Contr.

Spudding Date

Drig. Data

RUR**J. G. McGEHEE**

County Pratt State Kansas
 Sec. 1 (Blk.) 27 (Sur.) 13W Map No. 1
 Operator C R A & Beardmore Drlg.
 Well No. 1 Farm Calbeck "A"
 Elev. 1909 Location SE NE NE

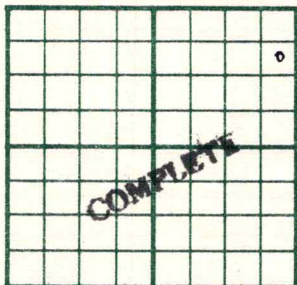

990 Ft. From N Line NE
330 Ft. From E Line Quarter

1st. Report

Completion AUG 27 1952

Remarks OWWO

Spudding Date

O.W.W.O.

Drlg. Data Oil well TD 4343

Viola 4138 Simp. 4237 Arb. 4324

5" @ 4317 OTD 4343 SP 4214 16/ 4189-93

38/ 4186-94 44/ 4167-78 A-frac

S/ 22 bo 14 bw 14 hr. PB 4121 86/ 4087

4106 SSO A-frac P/ 24 3/4 bo 29 bwpd

DP 4298 P/ 47 bo 70% water

Comp. 27 bopd 31 bw

County Pratt State Kansas

Sec. **1** (Blk. **27** (Sur. **13W** Map No.

Operator C R A & Beardmore

Well No. 1 Farm Calbeck "A"

Elev.	1909	Location	SE NE NE
-------	------	----------	----------

0

FIRST REPORT

990 Ft. From N Line NE

330 Ft. From E Line Quarter

1st. Report JUL 3 9 1952

Completion

Remarks OWWO

Spudding Date _____

Drlg. Data

Viola 4138 Simp. 4237 Arb. 4324

5" @ 4317 OTD 4343 SP 4214 16/ 4189-93

38/ 4186-94 44/ 4167-78 A-frac

S/ 22 bo 14 bw 14 hr.