

Section 1 Township 27 Range 13W

Well No. #1 Helmke "E"

Company Skelly

Iuka Pool

NORTH

WEST

EAST

SOUTH

0

Pratt



KANSAS

Sec. 1 Twp. 27 R. 13W

Well No. #1 Helmke "E" Farm

Skelly Company

Iuka Pool


_____ Ft. from N. Line

330' Ft. from S. Line

_____ Ft. from E. Line

330' Ft. from W. Line

SW SE

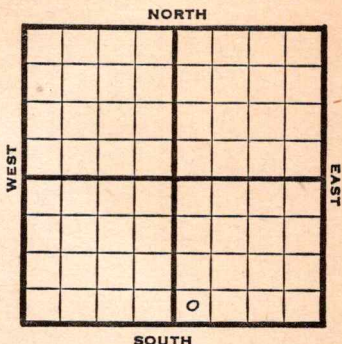

1948

Elev. 1905' REPORT

2/18

Location

2/25

"

3/3

"

3/10

"

3/17

"

3/24

"

3/31

8" @ 451'
Lansing 3745'
Drlg. 3780'

4/7

Lans. 3745'
Miss 4122'
Viola 4162'
Simp. Sd 4252'
TD 4300'

ABANDONED

Map No. _____ Sec. 1 Twp. 27 R. 13W

Well No. 1 Helmke "E"


Skelly _____ Company

FIRST REPORT

_____ Contractor

SW SE

SECTION PLAT

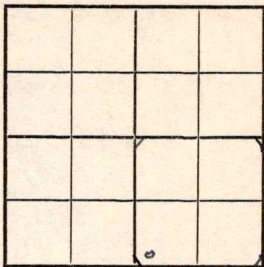

_____ Ft. from N. Line

330 Ft. from S. Line

_____ Ft. from E. Line

330 Ft. from W. Line

Pratt County

Location X

Rig up _____

Drilling and Remarks:

RECORD

Cased _____ in., _____ ft.

Sand _____

Gas _____

Oil _____

Total Depth _____

PRODUCTION

1st 24 hrs. Nat. _____

1st 24 hrs. after shot _____

Gas _____ Cu. Ft.

Dry Hole _____

Abandoned _____

Date

FEB 18 1948 19 _____ S. J. LEWIS Scout

Map No. 92 Sec. 1 Twp. 27 R. 13W

Well No. 1 Helmke "E"

Skelly Company

ABANDONED Contractor

SW SE

E. 1905
SECTION PLAT

 Ft. from N. Line

330 Ft. from S. Line

 Ft. from E. Line

330 Ft. from W. Line

		0	

Pratt County

Location

Rig up

Drilling and Remarks:

Laws 3745
Mis 4122
Vista 4162
Brig 4252

RECORD

Cased in., ft.

Sand

Gas

Oil

Total Depth 4300

PRODUCTION

1st 24 hrs. Nat.

1st 24 hrs. after shot

Gas Cu. Ft.

Dry Hole

Abandoned

Date

APR 7 1948

19

S. L. LEWIS

Scout