

KANSAS


Pratt

Form 51—5M—7-39—Palace

Section 1 Township 27 Range 13W

Well No. #1 Jackson

Company Marylyn Oil et al

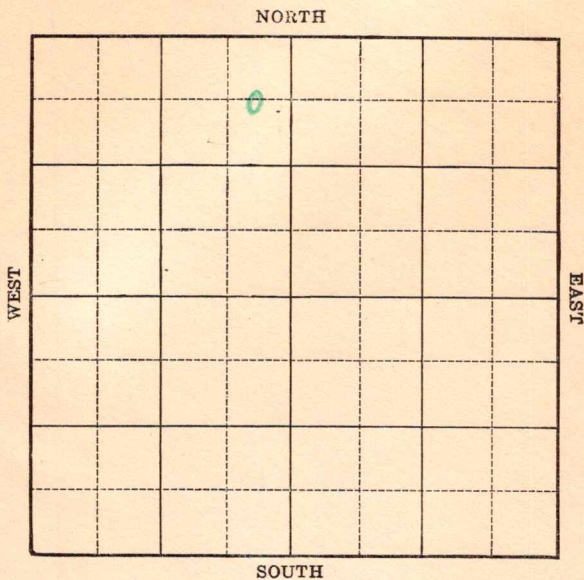

Sec. 1 Twp. 27 R. 13-W

Well No. #1 Jackson Farm

Marylyn Oil et al _____ Company


(Cunningham)

660 Ft. from N. Line

Ft. from S. Line

330 Ft. from E. Line

Ft. from W. Line

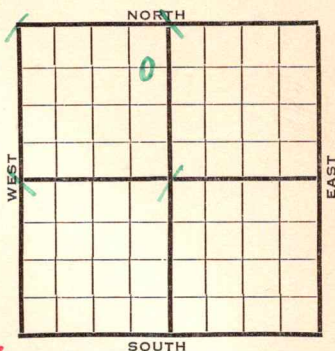

Elev. 1903

	REPORT
1940	
7/17	Location
7/25	Cellar.
8/2	R. Rig.
8/8	" "
8/14	" "
8/22	10" - 410' Drlg. 1010'
8/29	Neva 2500' Topeka 3198' Drlg. 3460'
9/5	Lansing 3721' SSO 3721-23 & 3895-3911' Viola 4032' SO 4176-78' Simp. sand 4212' 4221-31 Sat. Run 7".
9/12	7" - 4226' RUST.
9/19	Water 4241' TD 4312' SD.
9/26	Arb. 4316' T.D. 4339' 125' water, 75' oil 8 hours.
10/3	C. O.
	4316 1903 2413
	OVER

1940
 10/10 500 acid. No show.
 11 shots 4227-31' No help.
 SO & 700 water 7 hours.

10/17 T.D. 4342' No shows.

10/24 " " " "

10/31 " " " "

11/7 " " " "

11/14 " " " "

11/21 " " " "

11/27 " " " "

12/5 " " " "

12/11 Arb. 4316'
 7" - 4226'
 T.D. 4342'
 Water.

ABANDONED

Map No. 92 Sec. 1 Twp. 27 R. 13Well No. 1 JacksonMarylyn Oil et al

Company

Contractor

FIRST REPORT

C E L NE NW

660

Ft. from N. Line

Ft. from S. Line


330

Ft. from E. Line

Ft. from W. Line

CUNNINGHAM POOL

SECTION PLAT

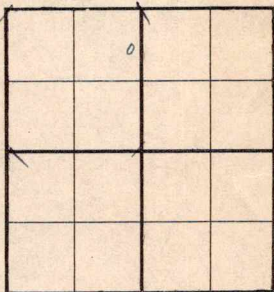Location X

Rig up

Drilling and Remarks:

RECORD

Cased _____ in., _____ ft.

Sand _____

Gas _____

Oil _____

Total Depth _____

PRODUCTION

1st 24 hrs. Nat. _____

1st 24 hrs. after shot _____

Gas _____ Cu. Ft.

Dry Hole _____

Abandoned _____

Date

JUL 17 1940 19

S. J. LEWIS

Scout

Map No. 92 Sec. 1 Twp. 27 R. 13WWell No. 1 JacksonMarylyn Oil etal Company

Contractor

ABANDONED

C E L NE NW

660 Ft. from N. Line Ft. from S. Line330 Ft. from E. Line Ft. from W. Line

CUNNINGHAM POOL

SECTION PLAT

Location Rig up

Drilling and Remarks:

AR 43167 "C 42 26Water.

RECORD

Cased in., ft.Sand Gas Oil Total Depth 4342

PRODUCTION

1st 24 hrs. Nat. 1st 24 hrs. after shot Gas Cu. Ft.Dry Hole Abandoned

Date

DEC 11 1940 19 S. J. LEWIS Scout