

KANSAS

Form 51-5M-7-40-Palace

Pratt


Section 1 Township 27 Range 13-W

Well No. #2 Jackson

Company Marylyn Oil et al

NORTH

Iuka pool

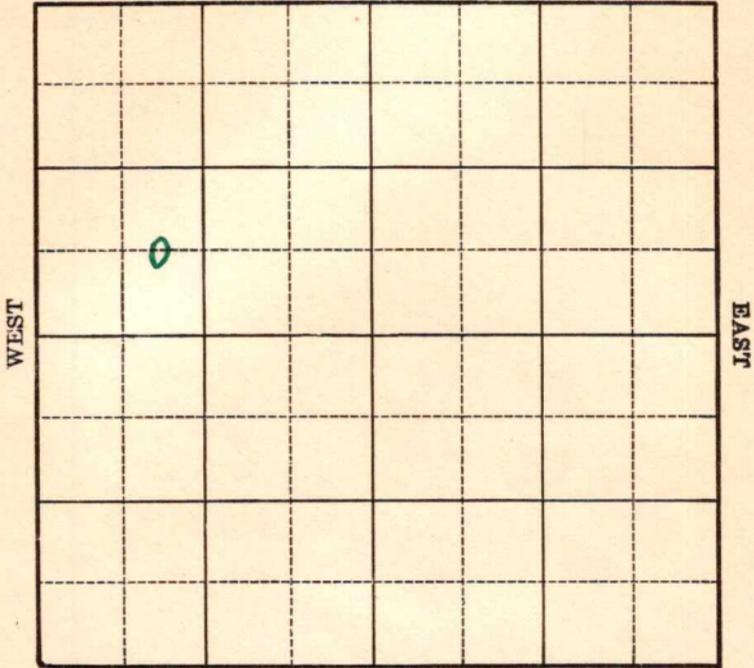

SOUTH

Sec. 1 Twp. 27 R. 13-W

Well No. #2 Jackson Farm

Marylyn Oil et al Company

(Iuka)


_____ Ft. from N. Line

660 Ft. from S. Line

_____ Ft. from E. Line

990 Ft. from W. Line

Elev. 1903

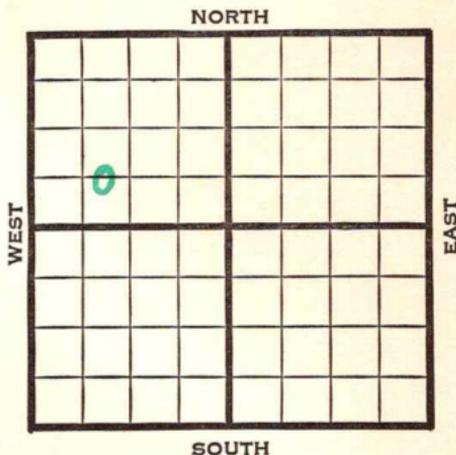

1941

REPORT

5/14

Location

5/22

Rotary.

5/28

10" - 400' WOC.

6/5

Drlg. 2990'

6/12

Lans. 3722' Fsg. 3980'

6/19

Viola 4131' Simp. 4216-18' T.D.

7" - 4214' RUST.

6/26

T.D. 4290' 36 shots 3888-97 1/2'

Shut down.

7/3

" "

7/9

Viola 4131'

4131

Simp. 4197'

1903

2728

T.D. 4290'

Water.

ABANDONED

Map No. 92 Sec. 1 Twp. 27 R. 13W

Well No. 2 Jackson

Marylyn Oil etal Company

FIRST REPORT Contractor

C E L SW NW

_____ Ft. from N. Line

660 Ft. from S. Line

_____ Ft. from E. Line

990 Ft. from W. Line

IUKA POOL

SECTION PLAT

o			

Location X

Rig up _____

Drilling and Remarks:

RECORD

Cased _____ in., _____ ft.

Sand _____

Gas _____

Oil _____

Total Depth _____

PRODUCTION

1st 24 hrs. Nat. _____

1st 24 hrs. after shot _____

Gas _____ Cu. Ft.

Dry Hole _____

Abandoned _____

Date

MAY 14 1941 19

S. J. LEWIS Scout

Map No. 92 Sec. 1 Twp. 27 R. 13W

Well No. 2 Jackson

Marylyn Oil etal Company

Contractor

ABANDONED

C E L S W N W

 Ft. from N. Line

660 Ft. from S. Line

 Ft. from E. Line

990 Ft. from W. Line

IUKA POOL

SECTION PLAT

RECORD

Location

Cased in., ft.

Rig up

Sand

Drilling and Remarks:

Gas

*Vista #131
Simp #197
Water.*

Oil

Total Depth 4290

PRODUCTION

1st 24 hrs. Nat.

1st 24 hrs. after shot

Gas Cu. Ft.

Dry Hole

Abandoned

Date

JUL 9 1941 19

S. J. LEWIS Scout