

Pratt


O.W.W.O.

KANSAS

Section 2 Township 27 Range 13W

Well No. #1 Evans

Company W + W Dr/g. Co.
M. B. Armer

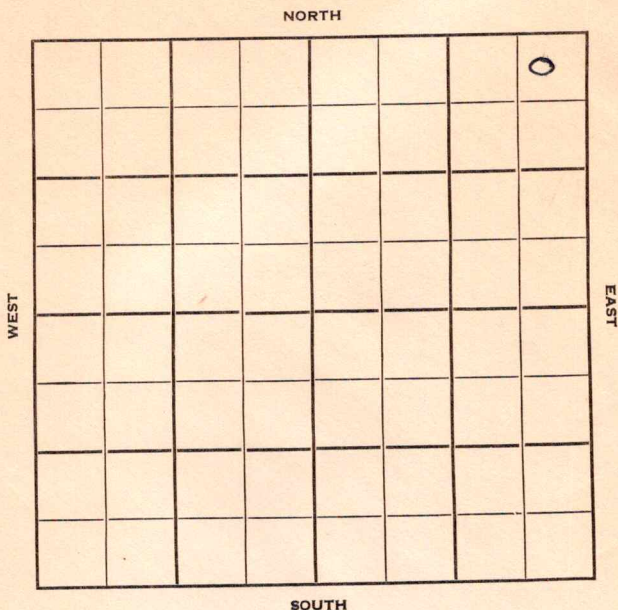

Pratt

KANSAS O.W.W.O. ✓

Sec. 2 Twp. 27 R. 13W

Well No. #1 Evans Farm

M. B. Armer

W & W Drlg Co.
Company

Armer

Contractor

Iuka - Carmi Pool

330

Ft. from N. Line

Ft. from S. Line


330

Ft. from E. Line

Ft. from W. Line

NE NE NE

CRA - DHM

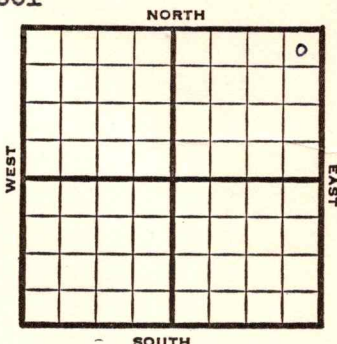

1952

Elav. 1916'

REPORT

10/1

MIR

10/8

8" @ 480'

Anhy 870

Drlg. 3070'

10/15

KC 3749

DST 3912-19, 1 hr., 30' SOCM

Drlg. 4048'

10/22

Simp. 4269'

DST 4273-4319', 1/2 hr, 550' oil

200' OCM, 1040# RTD 4325'

5" @ 4325'

10/29

CO 4325 gamma-ray 4278-86 500A

S/1 BOPH

11/5

D&A TD 4325' 8" @ 480

Anhy 870

KC 3749

DST 3912-19 open 1 hr. rec. 30' socm

Simp. 4269

DST 4273-4319 open 1/2 hr. rec. 550' oil

200' ocm 1040# TD 4325

5" @ 4325 CO to 4325 40/ 4278-86

500 A S/ 1 boph PB 4268

15/ 4256-61 500 A S/ 35' fluid ph

D&A

ABANDONED

OVER

1953

O.W.W.O.

#1 Evans

6/3

Oil Well

TD 4325'

KC 3749, Simp 4269,

OTD 4325'

CO to 4325'

Comp. 44 bopd.

FIRST REPORT

COMPLETED

County **Pratt** State **Kansas**
 Sec. **2** (Blk. **27** (Sur. **13W** Map No.
 (Twp.) (Rge.)
 Operator **M. B. Armer**
 Well No. **1** Farm **Evans**
 Elev. Location **NE NE NE**

FIRST REPORT

330 Ft. From **N** Line **NE**
330 Ft. From **E** Line Quarter
 1st. Report **OCT 1 1952**
 Completion
 Remarks **CRA - DHM**
Armer - Contr.
 Spudding Date

Drlg. Data

Iuka - Carmi Pool**M I R**

J. G. McGEHEE

County Pratt State KansasSec. 2 (Blk.) 27 (Sur.) 13W Map No.Operator M. B. ArmerWell No. 1 Farm EvansElev. 1916 Location NE NE NE

						0

330 Ft. From N Line NE330 Ft. From E Line Quarter

1st. Report

Completion NOV 5 1952Remarks Iuka-Carmi PoolArmer - Contr.

Spudding Date

Drlg. Data D & A TD 43258" @ 480 Anhy 870 KC 3749 DST 3912-19open 1 hr. Rec. 30' socm Simp. 4269DST 4273-4319 open $\frac{1}{2}$ hr. Rec. 550' oil200' ocm 1040# TD 4325 5" @ 4325CO to 4325 40/ 4278-86 500 AS/ 1 boph PB 4268 15/ 4256-61 500 AS/ 35' fluid phD. & A

J. G. McGEHEE

J.W.W.O.

County Pratt State Kansas
 Sec. 2 (Blk.) 27 (Sur.) 13W Map No.
 Operator W & W Drlg. Co. (was M.B. Armer)
 Well No. 1 Farm Evans
 Elev. 1916 Location NE NE NE

FIRST REPORT
COMPLETE

330 Ft. From N Line NE
 330 Ft. From E Line Quarter
 Ist. Report JUN 3 1953
 Completion JUN 3 1953
 Remarks W.O. ONWO

Spudding Date O.W.W.O.

Drlg. Data Oil well TD 4325

KC 3749 Simp. 4269 OTD 4325

CO to 4325 Comp. 44 bopd