

Form 51—5M—7-40—Palace

Pratt

Section 2 Township 27 Range 13-W

Well No. #1 Harrell "B"

Company Atlantic & Skelly

NORTH

Iuka Pool

WEST

EAST

SOUTH



KANSAS


Pratt

Sec. 2 Twp. 27 R. 13-WWell No. #1 Harrell "B" FarmAtlantic & Skelly Company

(Iuka)

 Ft. from N. Line330 Ft. from S. Line660 Ft. from E. Line Ft. from W. Line

Elev. 1894

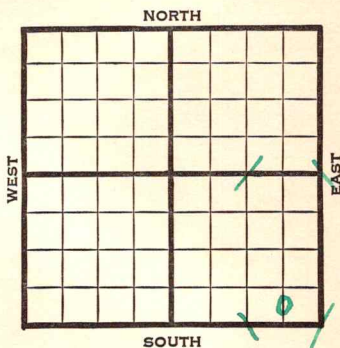

1941	REPORT
5/14	Location
5/22	Derrick.
5/28	"
6/5	8" - 468' Anhy 680'
	Drlg. 2090'
6/12	SD 2660'
6/19	Drlg. 3725'
6/26	Lans. 3750' Viola 4181'
	T.D. 4270½' 5" - 4255' RUST.
7/3	5000 acid. Testing.
7/10	Swab 15 oil per hour.
7/17	" " " "
7/23	Viola 4181 Simpson 4252
	5" @ 4255'
	TD 4270½
	3000 gals acid
	Depth Potential 533 bbls.
	37.4 Gravity
	COMPLETED

Map No. 92 Sec. 2 Twp. 27 R. 13WWell No. 1 Harrell "B"Atlantic & Skelly


Company

FIRST REPORT

Contractor

C S L SE SE

SECTION PLAT

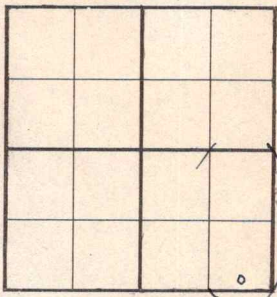 Ft. from N. Line330 Ft. from S. Line660 Ft. from E. Line Ft. from W. Line

IUKA POOL

Location XRig up

Drilling and Remarks:

RECORD

Cased in., ft.Sand Gas Oil Total Depth

PRODUCTION

1st 24 hrs. Nat. 1st 24 hrs. after shot Gas Cu. Ft.Dry Hole Abandoned

Date

MAY 14 1941 19 S. J. LEWIS Scout

Map No. 92 Sec. 2 Twp. 27 R. 13WWell No. 1 Harrell "B"Atlantic & Skelly Oil CompanyCOMPLETED

Contractor

C S L SE SE

SECTION PLAT

			o

Ft. from N. Line

330

Ft. from S. Line

660

Ft. from E. Line

Ft. from W. Line

IUKA POOL

RECORD

Location

Cased _____ in., _____ ft.

Rig up

Sand _____

Drilling and Remarks:

Gas _____

Oil _____

Total Depth 4270 1/2

PRODUCTION

1st 24 hrs. Nat. _____

1st 24 hrs. after shot _____

Gas _____ Cu. Ft.

Dry Hole _____

Abandoned _____

Vila 4181
5" @ 4255
Simpson 4252
2000 acid
Sept 1943
27 1/2 Gr.

Date

JUL 23 1941

19

S. J. LEWIS

Scout