


KANSAS

Haskell

Section 13 Township 27 Range 33-W

Well No. ~~#1~~ ~~#2~~ V. Tate "C"

Company National Assoc. Pet.

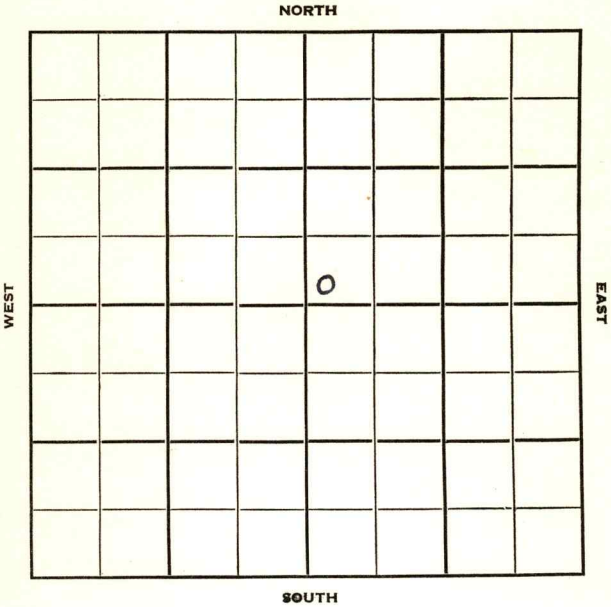

Haskell

KANSAS

Sec. 13 Twp. 27 R. 33W ✓

Well No. #1
#2 V. Tate "C" Farm

National Assoc. Pet. Company

Prime Drlg. - Contr. Contractor

Hugoton Pool


Ft. from N. Line

100' Ft. from S. Line

Ft. from E. Line

100' Ft. from W. Line

SW NE

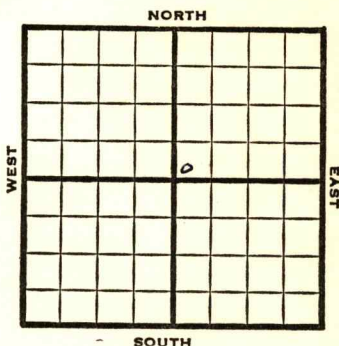

1950

Elev. 2907'

REPORT

11/8

Spud 11-4-50
8" @ 601'
Drlg. 1770'

1951
2/21

Spud 11-4-50
Gas well TD 2713'
8" @601
5" @2700' TD 2713'
Her. 2631', Krider 2650',
Win. 2694',
246/ 2631-72 1000 A
Comp. 6,430,000 gas 390#

COMPLETED

County Haskell State Kansas
 Sec. 13 (Blk.) 27 (Sur.) 33W Map No.
 Operator National Assoc. Pet.
 Well No. 2 Farm V. Tate "C"
 Elev. Location SW NE

100 Ft. From S Line NE
100 Ft. From W Line Quarter

1st. Report NOV 8 1950

Completion

Remarks

Prime Drlg. - Contr.

Spudding Date 11-4-50

Drlg. Data Hugoton Pool

8" @ 601 drlg. 1770


J. E. TYRA

County Haskell State Kansas
 Sec. 13 (Blk. 27) (Sur. 33W) Map No.

Operator National Assoc. Pet.

Well No. 1 Farm Tate "C"

Elev. 2907 Location SW NE

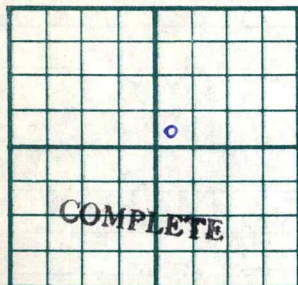

100 Ft. From S Line NE

100 Ft. From W Line Quarter

1st. Report

Completion FEB 21 1951

Remarks Hugoton Pool

Prime Drlg. - Contr.

Spudding Date 11-4-50

Drlg. Data Gas well TD 2713

8" @ 601 5" @ 2700 TD 2713 Her. 2631

Krider 2650 Win. 2694 246/ 2631-72

1000 A Comp. 6,430,000 gas 390#

J. E. TYRA

This was reported
#2 then changed
to #1. We must have
failed to send a
correction. #1 is
correct.

13-27-33W