


KANSAS

Section 13 Township 27 Range 39-W

Well No. #1 Mater "A"

Company Stanolind
Hugoton Pool

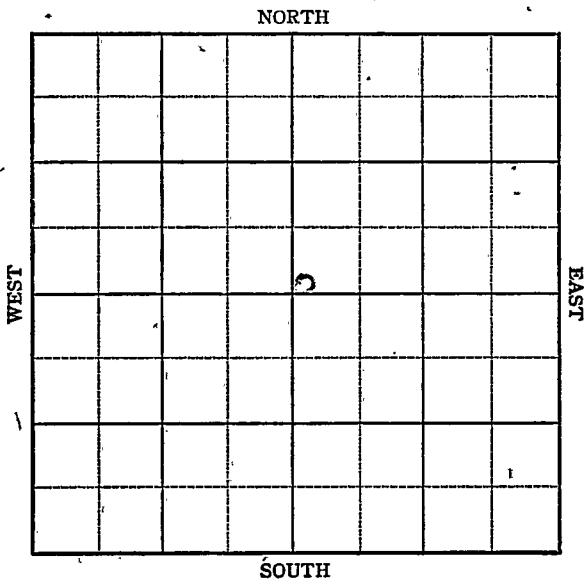

Sec. 13 Twp. 27 R. 39W

Well No. 1 Mater "A" Farm _____

Stanolind Company


Hugoton Pool

_____ Ft. from N. Line

50 _____ Ft. from S. Line

_____ Ft. from E. Line

50 _____ Ft. from W. Line

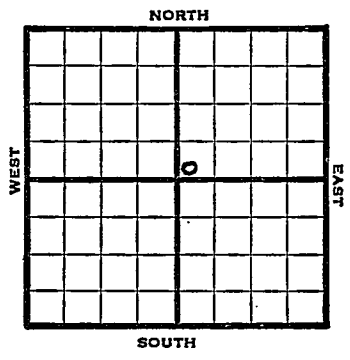

SW NE

1947

Elev 3180' REPORT

6/25

RUR

7/1

8" @ 645'
Drlg 2330'

7/8

TD 2560'
5" @ 2505'
RUST

7/16

168 shots 2452-80
6000 Acid
144 shots 2388-2412
3000 ACid

7/23

5" @ 2505'
Perf.
13,500 Acid.
5,647,00 Gas
R. Pr. 410#
T.D. 2560'
Complete

COMPLETED

Map No. _____ Sec. 13 Twp. 27 R. 39W

Well No. 1 Mater "A"

Stanolind Company

FIRST REPORT Contractor

SW NE

SECTION PLAT

_____ Ft. from N. Line

50 Ft. from S. Line

_____ Ft. from E. Line

50 Ft. from W. Line

		o	

Stanton County

Location _____

Rig up _____

Drilling and Remarks:

R U R

RECORD

Cased _____ in., _____ ft.

Sand _____

Gas _____

Oil _____

Total Depth _____

PRODUCTION

1st 24 hrs. Nat. _____

1st 24 hrs. after shot _____

Gas _____ Cu. Ft.

Dry Hole _____

Abandoned _____

Date

JUN 25 1947

19

S. J. LEWIS Scout

