


KANSAS

Section 13 Township 27 Range 12W

Well No. #1 Barnes Est.

Company Phillips etal.

NORTH

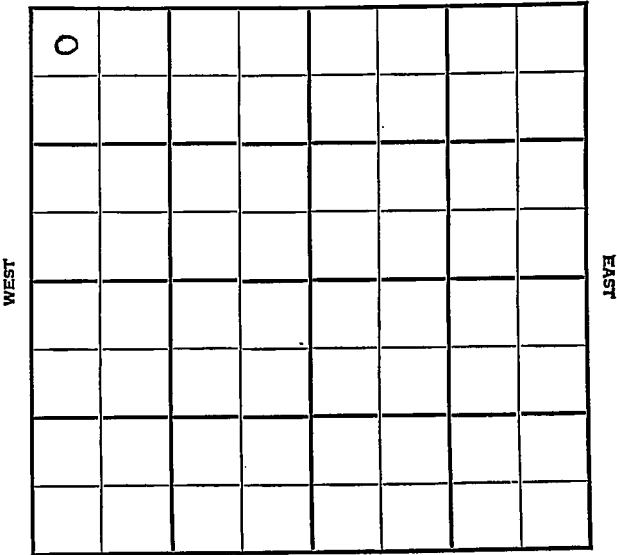

SOUTH

KANSAS

Pratt

Sec. 13 Twp. 27 R. 12W

Well No. #1 Barnes Est. Farm

Phillips et al Company

Wildcat


330' Ft. from N. Line

\_\_\_\_\_ Ft. from S. Line

\_\_\_\_\_ Ft. from E. Line

330' Ft. from W. Line

NW/C

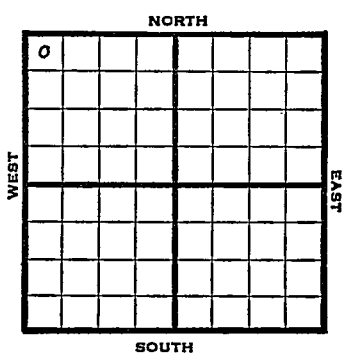

1948 E<sub>1</sub> 1863' REPORT

5/19 RUR

5/26 10" @ 217'  
WOD

6/1 Ft. Riley 1680'  
Drlg. 2645'

6/9 Lansing 3699'  
Drlg. 3933'

6/16 Mississippi 4151'  
Viola 4359'  
Simpson sd 4440'  
Drlg. 4465'

6/23 TD 4566'  
Arb. 4537'  
Aband.

**ABANDONED**

Map No. \_\_\_\_\_ Sec. 13 Twp. 27 R. 12W

Well No. 1 Barnes Est.

Phillips etal. \_\_\_\_\_ Company

FIRST REPORT \_\_\_\_\_ Contractor

NW/C

SECTION PLAT

330 Ft. from N. Line

\_\_\_\_\_ Ft. from S. Line

\_\_\_\_\_ Ft. from E. Line

330 Ft. from W. Line

o			

Pratt County

Location \_\_\_\_\_

Rig up \_\_\_\_\_

Drilling and Remarks:

R U R

RECORD

Cased \_\_\_\_\_ in., \_\_\_\_\_ ft.

Sand \_\_\_\_\_

Gas \_\_\_\_\_

Oil \_\_\_\_\_

Total Depth \_\_\_\_\_

PRODUCTION

1st 24 hrs. Nat. \_\_\_\_\_

1st 24 hrs. after shot \_\_\_\_\_

Gas \_\_\_\_\_ Cu. Ft.

Dry Hole \_\_\_\_\_

Abandoned \_\_\_\_\_

Date

MAY 19 1948

19

S. J. LEWIS

Scout

Map No. 54 Sec. 13 Twp. 27 R. 12W

Well No. 1 Barnes Est.

Phillips etal. Company

**ABANDONED**

Contractor

NW/C

E 11863  
SECTION PLAT

330 Ft. from N. Line

\_\_\_\_\_ Ft. from S. Line

\_\_\_\_\_ Ft. from E. Line

330 Ft. from W. Line

0			

Pratt County

Location \_\_\_\_\_

Rig up \_\_\_\_\_

Drilling and Remarks:

Oil 4567

RECORD

Cased \_\_\_\_\_ in., \_\_\_\_\_ ft.

Sand \_\_\_\_\_

Gas \_\_\_\_\_

Oil \_\_\_\_\_

Total Depth 4566

PRODUCTION

1st 24 hrs. Nat. \_\_\_\_\_

1st 24 hrs. after shot \_\_\_\_\_

Gas \_\_\_\_\_ Cu. Ft.

Dry Hole \_\_\_\_\_

Abandoned \_\_\_\_\_

Date

JUN 23 1948 19

S. J. LEWIS Scout