

Section 8 Township 27 Range 14 WWell No. # 1 EwbanksCompany Lion Oil

NORTH

							0

WEST

EAST

SOUTH

Pratt

KANSAS

Sec. 8 Twp. 27 R. 14WWell No. #1 Ewbanks FarmLion Oil CompanyD & M - Contr. Contractor

Wildcat


330' Ft. from N. Line

Ft. from S. Line

330' Ft. from E. Line

Ft. from W. Line

NE NE NE

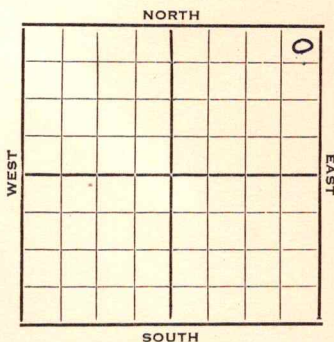

1951	Elev. 2007' REPORT
12/19	RUR
1952 2/5	Spud 12-19-51 Gas Well TD 4646 8" @ 854 Doug 3745 Sand 3792 Br lime 3872 Lans. 3902 DST 4045-60 opn 45 min. Rec. 25' vso & gcm DST 4070-4108 opn 1 hr 20 min. Rec. 300' gas 225' hgcm & SS0 125' gcsW EST 4130-45 opn 45 min. Rec. 30' vsocm Miss 4349 DST 4325-62 opn 1 hr. Rec. 700' gas 20' gcm Kh 4387 Viola 4441 Simp. 4535 Arb. 4630-46 TD 5" @ 4560 44/4496-4504 1000 A 48/4357-83 1000 A PB 4200 18/4181-87 11/4190-94 PB 4150 24/4139-45 1000 A PB 4090 23/4076-80 PB 3950 24/3918-26 SP 3885 Sq. off CO to 3943 40/3929-36 1000 A 1-3/4 mcfg S/2 1/2 bfph 95% wtr 3000 A F/4 1/2 boph 6 mcfg Comp. shut in gas well 8,388,000 gas plus 20 bopd COMPI ETED

J. G. McGEHEE


Drlg. Data

Sq. off CO to 3943 40/ 3929-36 1000 A

1 3/4 mcfg S/ 2 1/2 bfph 95% water

3000 A F/ 4 1/2 boph 6 mcfg

Comp. shut in gas well 8,388,000 gas plus
20 bopd

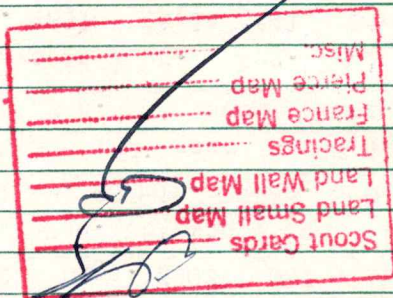

FEB 13 1957