


Pratt county

Section 12 Township 27 Range 14-W

Well No. #1, Reschke

Company Lion Chemical

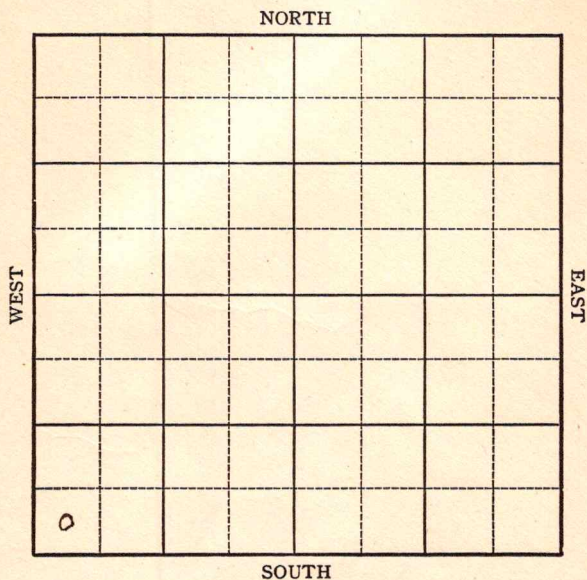

KANSAS

Pratt County

Sec. 12 Twp. 27 R. 14W

Well No. #1 Reschke Farm

Lion Chemical Company

Wildcat


Ft. from N. Line

330 Ft. from S. Line

Ft. from E. Line

330 Ft. from W. Line

S W/8

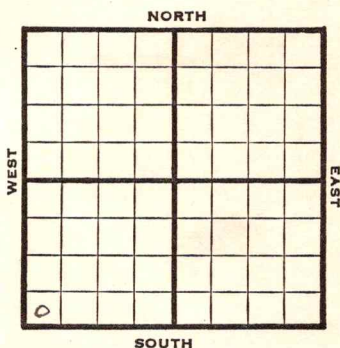

1946

1985

REPORT

9/11 8" @ 338'

WOC

9/18 Drlg 3315'

9/24 TD 3550'

Bad hole PB 380'

Drlg 2150'

10/1 Drlg 3615'

10/8 Lans 3878

4600 Drlg

10/16 Miss 4325'

Viola 4352'

Simp 4553'

Arb 4607'


TD 4635'

ABANDONED

Kansas Pool Name WildcatMap No. 92 Sec. 12 Twp. 27 R. 14WWell No. 1 ReschkeLion Chemical CompanyFIRST REPORT Contractor

S W/C

SECTION PLAT

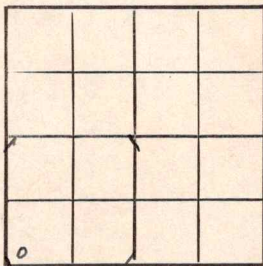

_____ Ft. from N. Line

330 Ft. from S. Line

_____ Ft. from E. Line

330 Ft. from W. LinePratt County

Location _____

Rig up _____

Drilling and Remarks:

8"@ 338 WOC

RECORD

Cased _____ in., _____ ft.

Sand _____

Gas _____

Oil _____

Total Depth _____

PRODUCTION

1st 24 hrs. Nat. _____

1st 24 hrs. after shot _____

Gas _____ Cu. Ft.

Dry Hole _____

Abandoned _____

Date

9-111946S. J. LEWIS

Scout

KANSAS

Kansas

Map No. 92 Sec. 12 Twp. 27 R. 14WWell No. 1 Reschke

Lion Chemical

Company

ABANDONED

Contractor

SW/C

E 11/1985

SECTION PLAT

_____ Ft. from N. Line

330 Ft. from S. Line

_____ Ft. from E. Line

330 Ft. from W. Line

Pratt County

Location _____

Rig up _____

Drilling and Remarks:

*Miss 4325.**Vista 4352**Sing 4553**Cr Y 4607*

RECORD

Cased _____ in., _____ ft.

Sand _____

Gas _____

Oil _____

Total Depth 4685

PRODUCTION

1st 24 hrs. Nat. _____

1st 24 hrs. after shot _____

Gas _____ Cu. Ft.

Dry Hole _____

Abandoned _____

Date

OCT 16 1946 19

S. J. LEWIS Scout