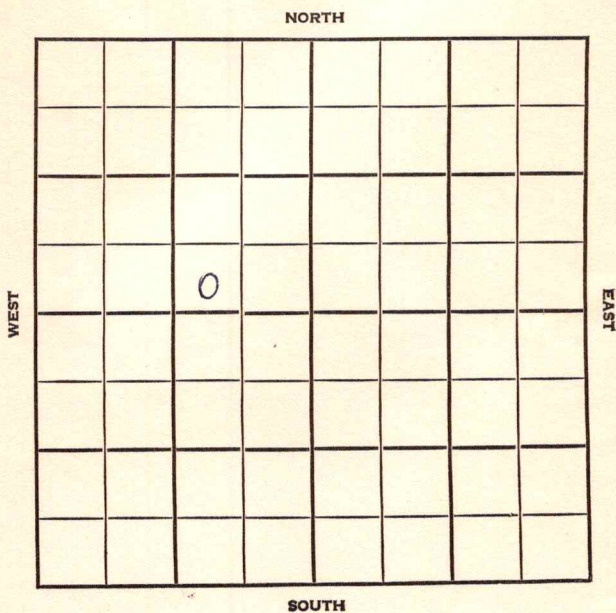


Section 11 Township 27 Range 14 WWell No. # 1 EubankCompany Lario

Pratt

KANSAS

SEC.	11	TWP.	27	R.	14W
------	----	------	----	----	-----

WELL NO.

#1 Eubank

FARM

COMPANY

Lario

CONTRACTOR

Buick
Wildcat.

Ft. from N. Line


330

Ft. from S. Line

990

Ft. from E. Line

Ft. from W. Line

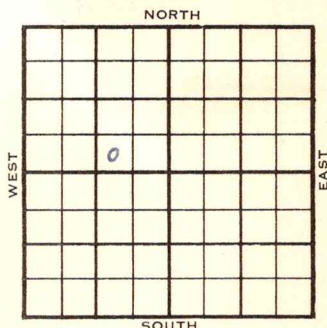

SW SE NW

	ELEVATION	REPORT
1954	1988'	

12/15 M I R

1955
1/19

Spud 12-14-54 - D&A

TD 4643'

13" @ 345'

Top. 3096', Heeb. 3694', Doug. 3764',
Br lime 3861', Lans 3882'DST 3906-28', opn 1 hr., rec. 1410'
gas, 30' VSOCM, 720' VSO&GCW, 360' wtr,
1390#

Penn. sd 4391'

DST 4393-4412', opn 1 hr., rec. 20'
SOCM, 0#Viola 4437', Simp. sh 4522', Simp
sd 4544'DST 4520-72', opn 1 hr., rec. 2510'
SW, 1515#

Arb. 4618'

Schl Tops: Doug. 3766', Br lime
3861', Lans. 3888', Cong. 4340',
Viola 4424', Simp. 4526', Arb. 4618'

D&A

ABANDONED

County **Pratt** State **Kansas**Sec. **11** (Blk.) **27** (Sur.) **14W** Map No.Operator **Lario**Well No. **1** Farm **Eubank**Elev. Location **SW SE NW****330** Ft. From **S** Line **NW****990** Ft. From **E** Line Quarter1st. Report **DEC 15 1954**

Completion


Remarks

Buick - Contr.

Spudding Date

Drlg. Data **Wildcat****M I R**

FABEN GILSTRAP

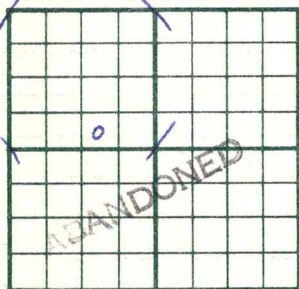County Pratt State KansasSec. 11 (Blk. Twp.) 27 (Sur. Rge.) 14W Map No. _____Operator LarioWell No. 1 Farm EubankElev. 1988 Location SW SE NW

330 Ft. From S Line NW

990 Ft. From E Line Quarter

1st. Report _____

Completion JAN 1 9 1955Remarks WildcatBuick - Contr.Spudding Date 12-14-54Drlg. Data D & A TD 464313" @ 345 Top. 3096 Heeb. 3694Doug. 3764 Br. lime 3861 Lans. 3882DST 3906-28 open 1 hr. Rec. 1410' gas30' vsocm 720' vso & gcw 360' wtr.1390# Penn. sd. 4391 DST 4393-4412open 1 hr. Rec. 20' socm 0#Viola 4437 Simp. sh. 4522 Simp. sd. 4544DST 4520-72 open 1 hr. Rec. 2510' sw1515# Arb. 4618 SCHLUMBERGER TOPS:Doug. 3766 Br. lime 3861 Lans. 3888Cong. 4340 Viola 4424 Simp. 4526Arb. 4618D & A

FABEN GILSTRAP