

Pratt

FORM 51

KANSAS

Section 13 Township 27 Range 14W

Well No. #1 Moon

Company Lario Oil & Gas

NORTH

WEST

EAST

SOUTH

0

SEC.	TWP.	R.
13	27	14W ✓

WELL NO.

1 Moon

FARM

COMPANY

Lario Oil & Gas

CONTRACTOR

Coppinger
Wildcat


990 Ft. from N. Line

Ft. from S. Line

990 Ft. from E. Line

Ft. from W. Line

SW NE SW

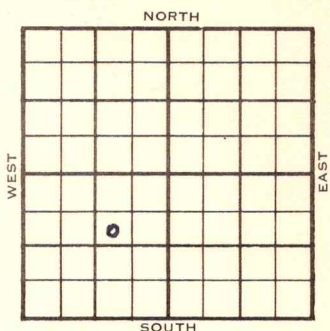

1954

ELEVATION

1979'

REPORT

2/24

Spud 2-17-54

8" @ 408'

Anhy 905'

Drlg. 2150'

3/3

Top 3274', Heeb 3658', Davy 3697'

Drlg 3838'

3/10

Br. L. 3874', KC 3897',

DST 4126'-40' 1 hr, 40' M / SSO

90' SW 1165#

B KC 4214'

DST 4260'-86' 1 hr, 10' M 30#

Miss 4325'

DST 4328'-45' 1/2 hr, 40' M 33#

DST 4380'-95' 1 hr, 30' M 0#

3/17

8x

Spud 2-17-54 D & A TD 4655

8" @ 408 Anhy 905 Top. 3274

Heeb 3658 Doug 3697 Br. lime 3874

KC 3897

DST 4126-40 open 1 hr rec 40' mud & SSO

90' SW 1165# B KC 4214

DST 4260-86 open 1 hr rec 10' mud 30#

Miss 4325

DST 4328-45 open 1/2 hr. rec 40' mud 33#

Viola 4377

1954
3/17

(Information continued)

DST 4380-95 open 1 hr rec 30' mud 0#

Simp 4531 Simp sd 4554

TD 4655' Arb. 4613'

D & A

ABANDONED

County **Pratt** State **Kansas**
 Sec. **13** (Blk.) **27** (Sur.) **14W** Map No.
 Operator **Lario Oil & Gas**
 Well No. **1** Farm **Moon**
 Elev. **1979** Location **SW NE SW**



990 Ft. From **N** Line **SW**
990 Ft. From **E** Line Quarter
 Ist. Report **FEB 24 1954**

Completion

Remarks

Coppinger - Contr.


Spudding Date **2-17-54**

Drlg. Data

Wildcat

8" @ 408 Anhy 905 drlg. 2150

County Pratt State Kansas
 Sec. 13 (Blk. Twp.) 27 (Sur. Rge.) 14W Map No. _____
 Operator Lario Oil & Gas
 Well No. 1 Farm Moon
 Elev. 1979 Location SW NE SW

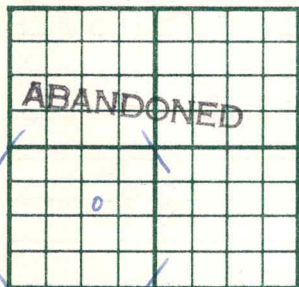

990 Ft. From N Line SW
990 Ft. From E Line Quarter
 1st. Report _____
 Completion MAR 17 1954
 Remarks Wildcat
Coppinger - Contr.
 Spudding Date 2-17-54

Drlg. Data D & A TD 4655
8" @ 408 Anhy 905 Top. 3274
Heeb. 3658 Doug. 3697 Br. lime 3874
KC 3897 DST 4126-40 open 1 hr. Rec.
40' mud & SSO 90' sw 1165# B KC 4214
DST 4260-86 open 1 hr. Rec. 10' mud
30# Miss. 4325 DST 4328-45 open $\frac{1}{2}$ hr.
Rec. 40' mud 33# Viola 4377 DST 4380-
95 open 1 hr. Rec. 30' mud 0#
Simp. 4531 Simp. sd. 4554 TD 4655
Arb. 4613

D & A

J. G. McGEHEE