

KANSAS

Pratt

Sec. 32 Twp. 27 R. 14-W

Well No. #1 Lemon Farm

Falcon, Seaborad, Atlantic, & Company

Barnsdall
(Wildcat)


330 Ft. from N. Line

_____ Ft. from S. Line

990 Ft. from E. Line

_____ Ft. from W. Line

Elev. 2027

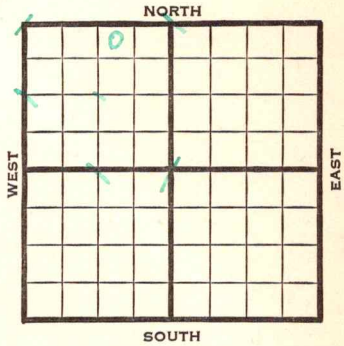

REPORT

1941

12/30 Derrick

1942

1/8 "

1/15 Rotary.

1/22 8" - 881' Drlg. 1426'

1/29 **Anhy. 877'** Drlg. 2705'

2/5 Drlg. 3783'

2/12 **Lans. 3945'** S.O. 4200' Drlg. 4305'

2/19 **Sand 4528-40'** **Miss. 4440'**

S/gas 4445-60' T.D. 4573'

SD repairs.

2/25 **Viola 4553'**

Simp. 4614'

Arb. 4712'

T.D. 4765'

No shows.

ABANDONED

Map No. 92 Sec. 32 Twp. 27 R. 14W

Well No. 1 Lemon

Falcon, Seaboard, Atlantic
& Barnsdall Company

~~FIRST REPORT~~ Contractor

NW NE NW


330 Ft. from N. Line

_____ Ft. from S. Line

990 Ft. from E. Line

_____ Ft. from W. Line

SECTION PLAT

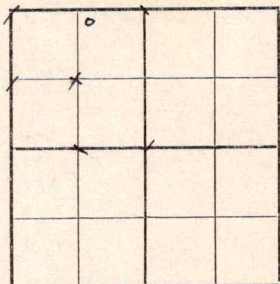

WI LDCAT

Location _____

Rig up _____

Drilling and Remarks:

Derrick

RECORD

Cased _____ in., _____ ft.

Sand _____

Gas _____

Oil _____

Total Depth _____

PRODUCTION

1st 24 hrs. Nat. _____

1st 24 hrs. after shot _____

Gas _____ Cu. Ft.

Dry Hole _____

Abandoned _____

Date

DEC 30 1941 19

S. J. LEWIS Scout

Pratt

KANSAS

Map No. 92 Sec. 32 Twp. 27 R. 14W

Well No. 1 Lemon

Falcon & Seaboard Company

Atlantic & Barrdall

ABANDONED Contractor

NW NE NW

330 Ft. from N. Line

_____ Ft. from S. Line

990 Ft. from E. Line

_____ Ft. from W. Line

SECTION PLAT

WILDCAT

Location _____

Rig up _____

Drilling and Remarks:

Via 4553
Imp 4614
Cr 4712
Noshors

RECORD

Cased _____ in., _____ ft.

Sand _____

Gas _____

Oil _____

Total Depth 4765

PRODUCTION

1st 24 hrs. Nat. _____

1st 24 hrs. after shot _____

Gas _____ Cu. Ft.

Dry Hole _____

Abandoned _____

Date

FEB 25 1942 19

S. J. LEWIS Scout