


Pratt

Section 26 Township 27 Range 14-W

Well No. 1 Elliot

Company Champlin Refining

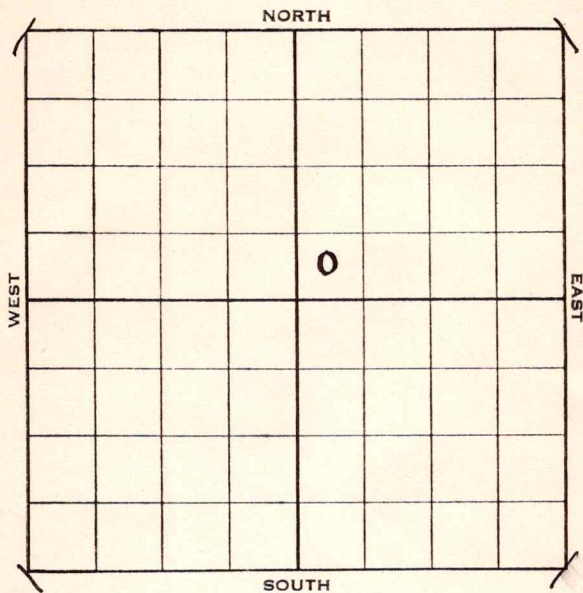

Sec. 26 Twp. 27 R. 14-W

Well No. #1 Elliot Farm

Champlin Refg.


Company

_Ft. from N. Line

330 Ft. from S. Line

_Ft. from E. Line

330 Ft. from W. Line

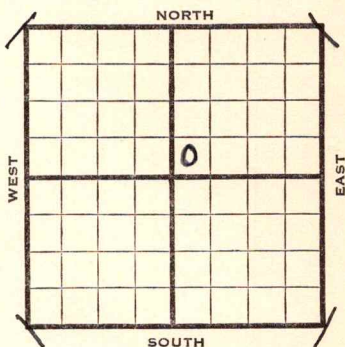

Ele v. 1941

1938	REPORT
8/17	B. R. R.
8/26	R. R.
9/2	13" - 296'. Anhy 840'.
	Dlg. 2460'.
9/9	Topeka 3100'. K. C. 3845'.
	Core 3900-18' no shows.
	Core 3950-60 no shows.
9/16	Base K. C. 4120'. Miss. 4250'.
	Viola 4390'. Cong. 4525'.
	Dlg. 4545'.
9/23	Arb. 4603'. T. D. 4857'. No shows. Fsg.
9/28	Arb. 4603'.
	T. D. 4857'.
	ABANDONED

Pratt

KANSAS

Map No. 92 Sec. 26 Twp. 27 R. 14WWell No. 1 Elliott

Champlin Refg.

Company

Contractor

ABANDONED

SW NE

 Ft. from N. Line330 Ft. from S. Line Ft. from E. Line330 Ft. from W. Line

SECTION PLAT

		0	

Location Rig up

Drilling and Remarks:

DVA

RECORD

Cased in., ft.Sand Arb 4603Gas Oil Total Depth 4857

PRODUCTION

1st 24 hrs. Nat. 1st 24 hrs. after shot Gas Cu. Ft.Dry Hole Abandoned

Date

SEP 28 1938

19

H. D. Hatfield Scout

Pratt

KANSAS

Map No. 92 Sec. 26 Twp. 27 R. 14WWell No. 1 Elliot

Champlin Refining

Company

Contractor

FIRST REPORT

SW NE


Ft. from N. Line

330 Ft. from S. Line

Ft. from E. Line

330 Ft. from W. Line

SECTION PLAT

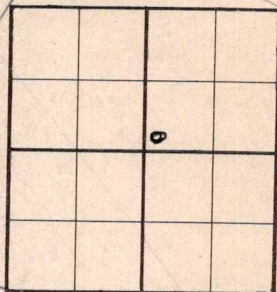

Location _____

Rig up _____

Drilling and Remarks:

BRR

RECORD

Cased _____ in., _____ ft.

Sand _____

Gas _____

Oil _____

Total Depth _____

PRODUCTION

1st 24 hrs. Nat. _____

1st 24 hrs. after shot _____

Gas _____ Cu. Ft.

Dry Hole _____

Abandoned _____

Date

AUG 17 1938 19

H. D. Hatfield Scout