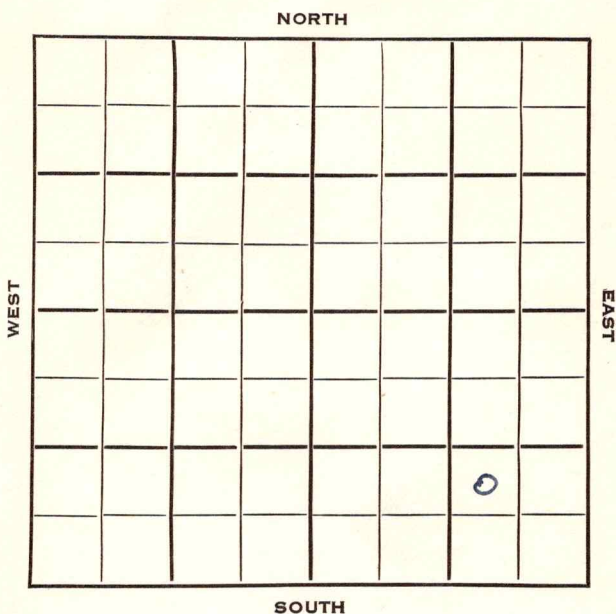


Section 28 Township 27 Range 14WWell No. #1 VanattaCompany Elreco

Sec. 28 Twp. 27 R. 14WWell No. #1 Vanatta FarmElreco

Company

Sterling
Wildcat


Contractor

Ft. from N. Line

990 Ft. from S. Line990 Ft. from E. Line

Ft. from W. Line

NW SE SE

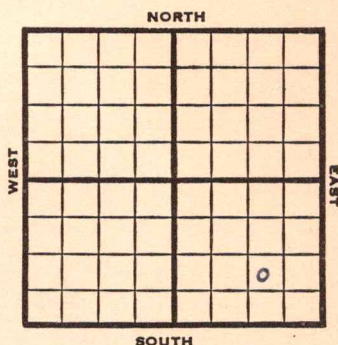

1953

Elev. 1953' REPORT

7/14

MIRT

7/22

8" @ 415' w/250

Anhy 895

Drlg 3020'

7/29

Heeb 3703' Tor 3724' Br li 3871

Lans 3893'

DST 4038-53, 1/2 hr, 10' M

B KC 4203

Drlg. 4325'

8/5

Spud 7-14-53 D & A TD 4652'

8" @ 415 Anhy 895 Heeb 3703

Tor. 3724 Br lime 3871 Lans 3893

DST 4038-53 open 1/2 hr rec 10' mud

B KC 4203 Cong 4332 Miss 4346

Misener 4410' Viola 4421

Simp 4535' Arb. 4639 TD 4652'

D & A

ABANDONED

County Pratt State KansasSec. 28 (Blk.) 27 (Sur.) 14W Map No.Operator ElrecoWell No. 1 Farm VanattaElev. Location NW SE SE

FIRST REPORT

990 Ft. From S Line SE

990 Ft. From E Line Quarter

1st. Report JUL 1 + 1953

Completion

Remarks


Sterling - Contr.

Spudding Date

Drlg. Data Wildcat

MIRT

J. G. McGEHEE

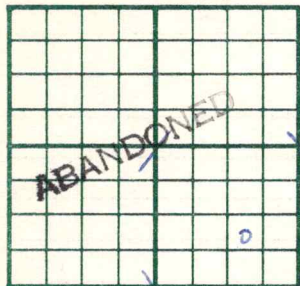County Pratt State KansasSec. 28 (Blk.
Twp.) 27 (Sur.
Rge.) 14W Map No.Operator ElrecoWell No. 1 Farm VanattaElev. 1953 Location NW SE SE990 Ft. From S Line SE990 Ft. From E Line Quarter1st. ReportCompletion AUG 5 1953Remarks WildcatSterling Drlg. - Contr.Spudding Date 7-14-53Drlg. Data D & A TD 46528" @ 415 Anhy 895 Heeb. 3703Tor. 3724 Br. lime 3871 Lans. 3893DST 4038-53 open $\frac{1}{2}$ hr. Rec. 10' mudB KC 4203 Cong. 4332 Miss. 4346Misener 4410 Viola 4421 Simp. 4535Arb. 4639 TD 4652D & A

J. G. McGEHEE