



Pratt

KANSAS

Sec. 14 Twp. 27 R. 11W

Well No. #1 Park Farm

Cities Service et al Company

Wildcat (Rine Drlg., Cont.) NORTH

\_\_\_\_\_ Ft. from N. Line

990'


\_\_\_\_\_ Ft. from S. Line

990'

\_\_\_\_\_ Ft. from E. Line

\_\_\_\_\_ Ft. from W. Line

NW SE SW

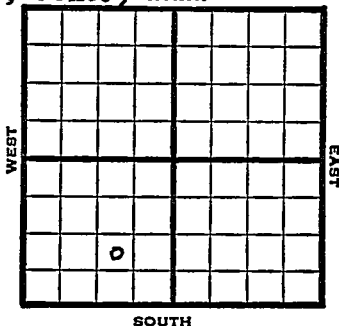

1949

Elev 1808'

REPORT

7/13

RUR

7/20

8" @ 795'

Drlg 2995'

7/27

Douglas 3459'

Lansing 3626'

Miss 4082'

Drlg 4260'

8/3

TD 4532'

Viola 4313

Simp 4398'

Arb. 4478'

Aband.

**ABANDONED**

Map No. \_\_\_\_\_ Sec. 14 Twp. 27 R. 11W

Well No. 1 Park

Cities Service etal. \_\_\_\_\_ Company

Rine Drlg. \_\_\_\_\_ Contractor

NW SE SW

**FIRST REPORT  
SECTION FLAT**

\_\_\_\_\_ Ft. from N. Line

990 Ft. from S. Line

990 Ft. from E. Line

\_\_\_\_\_ Ft. from W. Line


Pratt County

**RECORD**

Location \_\_\_\_\_

Cased \_\_\_\_\_ in., \_\_\_\_\_ ft.

Rig up \_\_\_\_\_

Sand \_\_\_\_\_

Drilling and Remarks: \_\_\_\_\_

Gas \_\_\_\_\_

Oil \_\_\_\_\_

R U R

Total Depth \_\_\_\_\_

**PRODUCTION**

1st 24 hrs. Nat. \_\_\_\_\_

1st 24 hrs. after shot \_\_\_\_\_

Gas \_\_\_\_\_ Cu. Ft.

Dry Hole \_\_\_\_\_

Abandoned \_\_\_\_\_

Date

JUL 13 1949

19

S. J. LEWIS

Scout

Kansas

Wildcat

Map No. K34 Sec. 14 Twp. 27 R. 11WWell No. 1 Park

Cities Service etal. \_\_\_\_\_ Company

**ABANDONED**

Contractor \_\_\_\_\_

NW SE SW

*E. 11908*  
SECTION PLAT

\_\_\_\_\_ Ft. from N. Line

990 Ft. from S. Line990 Ft. from E. Line

\_\_\_\_\_ Ft. from W. Line

	6		

Pratt County

Location \_\_\_\_\_

Rig up \_\_\_\_\_

Drilling and Remarks:

*Vista 4313**Sinj 4398**Carb 4478*

## RECORD

Cased \_\_\_\_\_ in., \_\_\_\_\_ ft.

Sand \_\_\_\_\_

Gas \_\_\_\_\_

Oil \_\_\_\_\_

Total Depth 4532

## PRODUCTION

1st 24 hrs. Nat. \_\_\_\_\_

1st 24 hrs. after shot \_\_\_\_\_

Gas \_\_\_\_\_ Cu. Ft.

Dry Hole \_\_\_\_\_

Abandoned \_\_\_\_\_

Date

Aug 3 1949S. J. LEWIS Scout