


Section 14 Township 27 Range 1W

Well No. 1 Allen

Company Chas. Gould

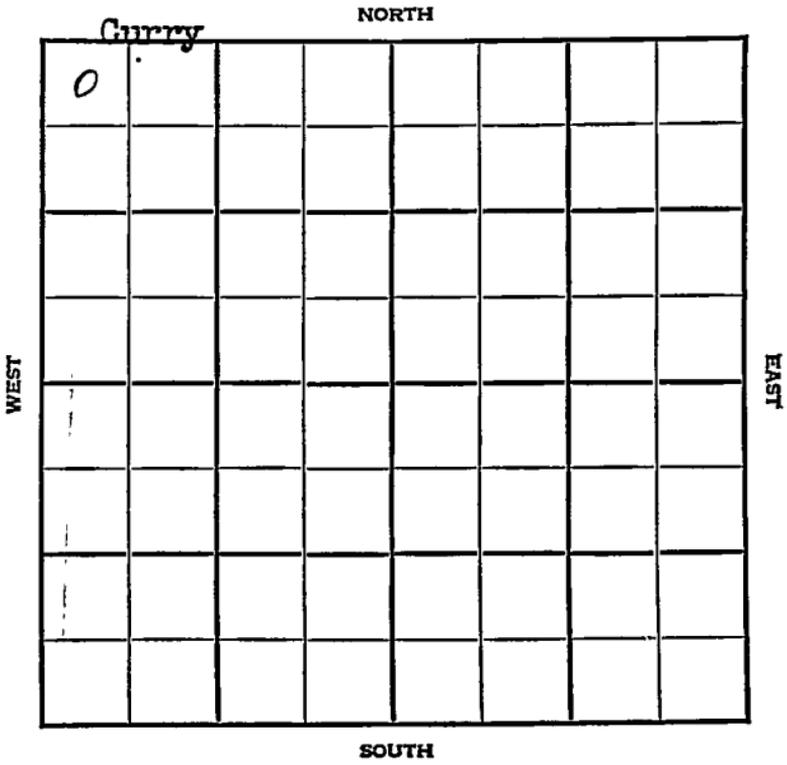



Sec. 14 Twp. 27 R. 1W

Well No. #1 Allen Farm

Chas. Gould Company

Curry Pool


330' Ft. from N. Line

_____ Ft. from S. Line

_____ Ft. from E. Line

330' Ft. from W. Line

NW/C

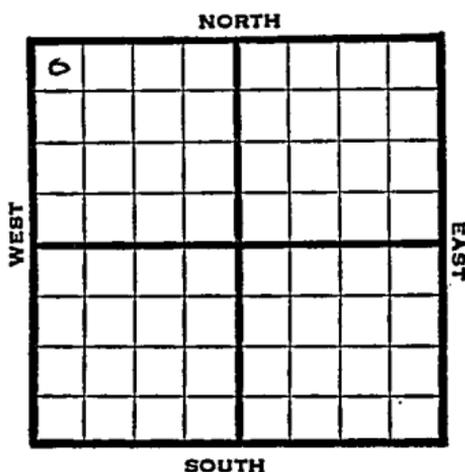

1948 Elev. 1319' REPORT

3/3 Location

3/10 RUR

3/17 8" @ 112'
Drlg. 708'

3/24 Lansing 2632'
Drlg. 2756'

3/31 Miss 3155'
TD 3200'

ABANDONED

Map No. _____ Sec. 14 Twp. 27 R. 1W

Well No. 1 Allen

Chas. Gould Company

FIRST REPORT Contractor

NW/c


SECTION PLAT

330 Ft. from N. Line

_____ Ft. from S. Line

_____ Ft. from E. Line

330 Ft. from W. Line

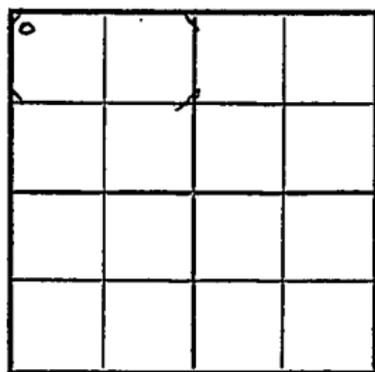

Sedgwick County

Location X

Rig up _____

Drilling and Remarks:

RECORD

Cased _____ in., _____ ft.

Sand _____

Gas _____

Oil _____

Total Depth _____

PRODUCTION

1st 24 hrs. Nat. _____

1st 24 hrs. after shot _____

Gas _____ Cu. Ft.

Dry Hole _____

Abandoned _____

Date

MAR 3 1948 19_____

S. J. LEWIS Scout

Map No. 38 Sec. 14 Twp. 27 R. 1W

Well No. 1 Allen

Chas. Gould Company

ABANDONED

Contractor

NW/C

E. J. B. B.

SECTION PLAT

330 Ft. from N. Line

 Ft. from S. Line

 Ft. from E. Line

330 Ft. from W. Line

6			

Sedgwick County

Location

Rig up

Drilling and Remarks:

Miss 8155

RECORD

Cased in., ft.

Sand

Gas

Oil

Total Depth: 3200

PRODUCTION

1st 24 hrs. Nat.

1st 24 hrs. after shot

Gas Cu. Ft.

Dry Hole

Abandoned

Date

MAR 31 1948

19

S. J. LEWIS

Scout