


DX 78-1 Pratt

KANSAS

Section 16 Township 27 Range 15W

Well No. #1 Lemon

Company N C R A

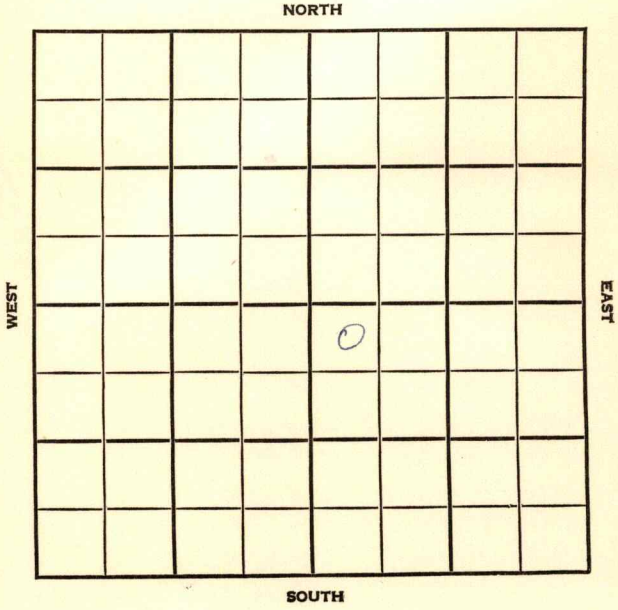

Pratt

SEC. 16	TWP. 27	R. 15W
------------	------------	-----------

WELL NO. #1 Lemon FARM

COMPANY N C R A


CONTRACTOR B & R Carber-Robbins

_____ FT. FROM N. LINE

_____ FT. FROM S. LINE

_____ FT. FROM E. LINE

_____ FT. FROM W. LINE

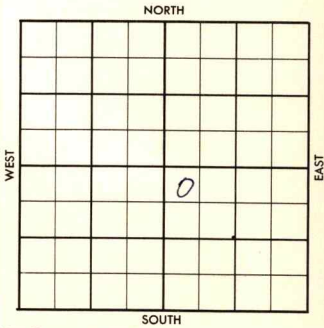

NW NW SE

CRA - DHM

1956	ELEVATION	REPORT
------	-----------	--------

8-22 RUR

EP 19 56

DST 4558-95 1hr
20' Md BHP 40/20" DST
4680-4763 1hr see 10' Md
BHP 84/20"

D&A.

County Pratt Elev. _____
 Sec. 16 Twp. 27 Rgs. 15W
 Company N C R A
 Farm Name Lemon No. 1

TOPS	DEPTH	LOG	DATUM	Loc. in Sec.
Anh.				NW NW SE
Tp.				
H.				
Tr.				
Dg.				
Bl.				
L.				Geol. _____
K.C.				Contr. _____
B.K.C.				B & R
Ce.				Pool _____
C.				Carber-Robbins
M.				
M.				
K.				
Mz.				
Mq.				
V.				
S.				
S.				
A.				
R.				
Pe.				
G.				
T.D.				

FIRST REPORT

AUG 22 1956

Date Comm. RUR GRA - DHM

25

Co.
Lse.
No.
Sec.
T.
R.