

Section 19 Township 27 Range 15-WWell No. #1 BarbeeCompany J H Tatlock

0							

NORTH

WEST

EAST

SOUTH

Pratt

KANSAS

Sec. 19 Twp. 27 R. 15W

Well No. #1 Barbee Farm

J. H. Tatlock Company

Rine Drlg. - Contr. Contractor

Wildcat


Ft. from N. Line

330' Ft. from S. Line

Ft. from E. Line

330' Ft. from W. Line

SW SW SW

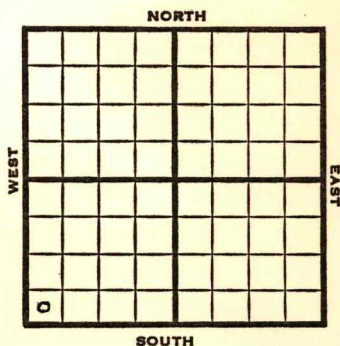

1951

Elev 2087' REPORT

1/3

Spud 12-30-50

10" @ 989

WOC

1/24

10" @ 989

Anhy 983

KC 4033

Miss 4540

DST 4595-4608 opn 1 hr rec 30' mud


Viola 4650

Simp 4725

Arb 4854-86 TD

D&A TD 4886'

ABANDONED

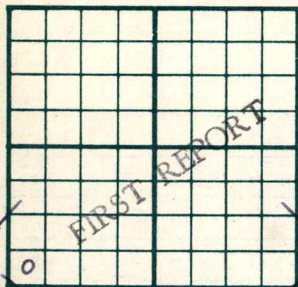County **Pratt** State **Kansas**Sec. **19** (Blk. Twp.) **27** (Sur. Rge.) **15W** Map No.Operator **J. H. Tatlock**Well No. **1** Farm **Barbee**Elev. Location **SW SW SW****330** Ft. From **S** Line **SW****330** Ft. From **W** Line Quarter1st. Report **JAN 3 1951**

Completion

Remarks

Rine Drlg. - Contr.Spudding Date **12-30-50**Drlg. Data **Wildcat****10" @ 989 WOC**

J. E. TYRA

County Pratt State Kansas
 Sec. 19 (Blk.
Twp.) 27 (Sur.
Rge.) 15W Map No. _____
 Operator J. H. Tatlock
 Well No. 1 Farm Barbee
 Elev. 2087 Location SW SW SW



330 Ft. From S Line SW
330 Ft. From W Line Quarter
 1st. Report _____
 Completion JAN 24 1951
 Remarks Wildcat
Rine Drlg. - Contr.
 Spudding Date 12-30-50

Drlg. Data D & A TD 4886
10" @ 989 Anhy 983 KC 4033 Miss. 4540
DST 4595-4608 open 1 hr. Rec. 30' mud
Viola 4650 Simp. 4725 Arb. 4854-86 TD
D & A

J. E. TYRA