


Pratt

KANSAS

SECTION 32 TOWNSHIP 27 RANGE 15W

WELL NO. #1 Bryant

COMPANY Musgrove Petr. Corp.

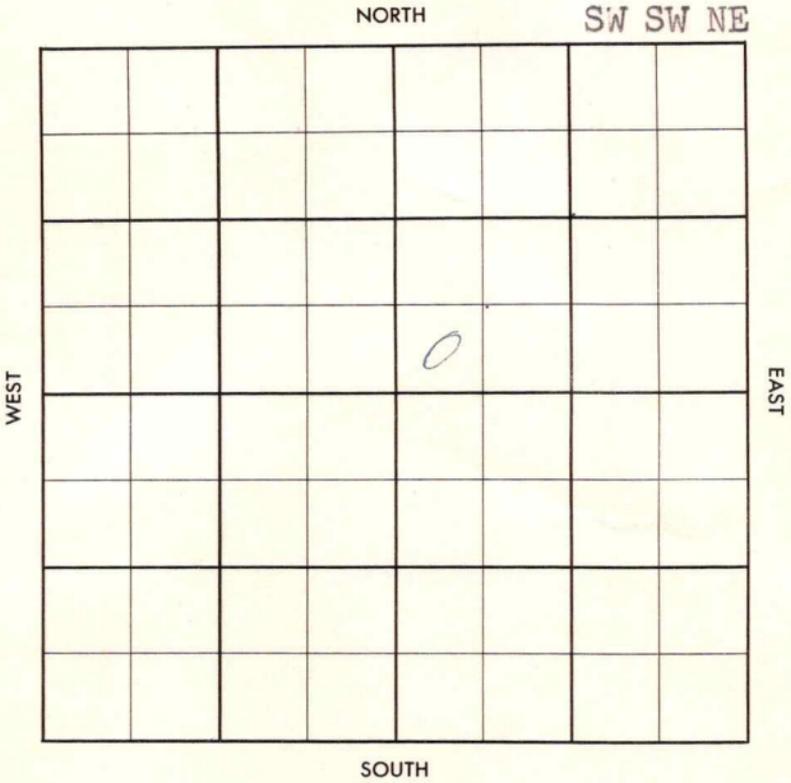

WILDCAT

FORM 513 SUNRAY

County Pratt Elev. _____
Sec. 32 Twp. 27 Rge. 15W
Company Musgrove Pet. Corp.
Farm Name Bryant No. 1

TOPS	DEPTH	LOG	DATUM	Loc. in Sec.
Anh.				SW SW NE
TP.				
H.				
Tr.				
Dg.				
Bl.				
L.				
K.C.				Geol. _____
B.K.C.				Contr. _____
Ce.				<u>Musgrove Tool</u>
C.				
M.				Pool
M.				<u>Wildcat</u>
K.				
Mz.				
Mo.				
V.				
S.				
S.				
A.				
R.				
PE.				
G.				
T.D.				

APR 17 '57		
	0	
FIRST REPORT		

Date Comm. 4-11-57
8" @ 318/300, Drlg. 2750

~~26~~

Co.

Sec.

T.

R.

County Pratt Elev. 2060
 Sec. 32 Twp. 27 Rge. 15W
 Company Musgrove Pet. Corp.
 Farm Name Bryant No. 1

TOPS	DEPTH	LOG	DATUM	Loc. in Sec.
				SW SW NE
	3891	3892		
Sp. 32	3931	3932		
Bl.	4057	4057		
L.	4074	4078		Geol.
K.C.				Contr.
B.K.C.	4393	4394		
Ce. Sh	4523	4535		
Ce. sd	4577	4546		Musgrove Tools
M.	4574	4575		
M.				Pool
K. sh	4595	4595		Wildcat
Mz. Kd sd	4639	4642		
Ma.				
V.	4675	4674		
S. Sh	4763	4766		
S. sd	4769	4772		
A.				
R.				
PE.				
G.				
T.D.	4820			

MAY 8 57
 ABANDONED
 0
 1/2 mile

Date Comm. 4-11-57
 8" @ 313/300, Drlg. 2750 APR 24 '57 ϕ 3251
 MAY 9 '57 DST 4346-4370 @ 1 hr
 310' GIP rec. 34' oil cut 9554 Md
 + 31' SOC 9554 Md FPO BHP
 295/20" ϕ 4511 MAY 12 '57 X DST
 4546-65 PKR Failed DST 4533-65
 Tool plgd. DST 4533-65 @ 1 hr rec
 40' Md FP 30-45 1BHP 60 FBHP
 45# Hyd. Press 2485 DST 4568

Co.
 L.S.
 No.
 Sec.
 T.
 R.

- 4600 cgs 1 hr 360' gas rec 115'
oc gssy Md + 30' ocw gssy Md
FP 45-75 BHP 910 RTP
4820

D&A