


Grant

KANSAS

Section 15 Township 27 Range 37W

Well No. #2 Canary

Company Northern Natural Gas

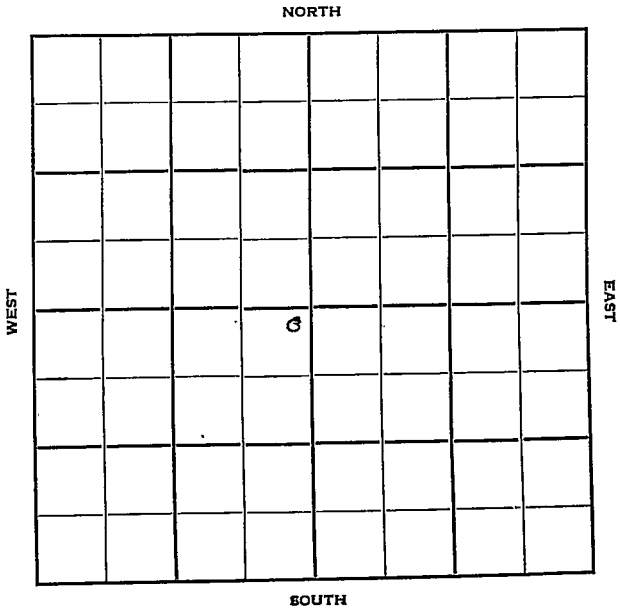

Grant

KANSAS

Sec. 15 Twp. 27 R. 37W ✓

Well No. #2 Canary Farm

Northern Natural Gas Company

Contractor


Hugoton Pool
200' Ft. from N. Line

 Ft. from S. Line

200' Ft. from E. Line

 Ft. from W. Line

NE SW

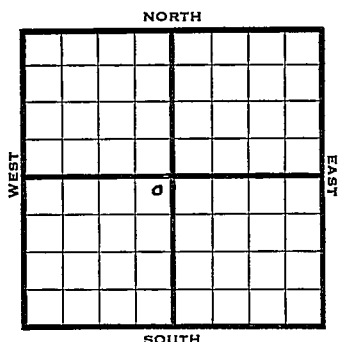

1950

Elev 3081

REPORT

4/19

Spud 4-15-50

10" @ 417'

Drlg. 500'

6/7

TD 2627

10" @ 417

7" @ 2370

289' of 5" liner

27,275,000 cu ft gas pr day

Hev 2365

Kr 2395

Win 2451

Ft R 2508 -

Mutfield 2622


Completed

COMPLETED

Map No. _____ Sec. 15 Twp. 27 R. 37WWell No. 2 Canary_____
Northern Natural Gas Company_____
Contractor

NE SW

SECTION PLAT

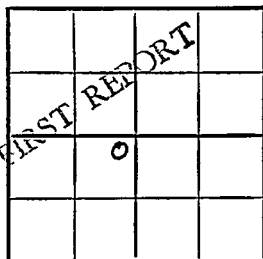200 Ft. from N. Line_____
Ft. from S. Line200 Ft. from E. Line_____
Ft. from W. Line

Grant County

Location _____

Rig up _____

Drilling and Remarks:

Spud 4-15-50

10" @ 417

drlg. 500

RECORD

Cased _____ in., _____ ft.

Sand _____

Gas _____

Oil _____

Total Depth _____

PRODUCTION

1st 24 hrs. Nat. _____

1st 24 hrs. after shot _____

Gas _____ Cu. Ft.

Dry Hole _____

Abandoned _____

Date

APR 19 1950 19J. E. TYRA Scout

Kansas

Map No. _____ Sec. 15 Twp. 27 R. 37W


Well No. 2 Canary

Northern Natural Company

NE SW

El. 3081 Contractor

SECTION PLAT

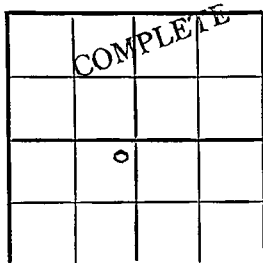

200 Ft. from N. Line

_____ Ft. from S. Line

200 Ft. from E. Line

_____ Ft. from W. Line

Grant

RECORD

Location _____

Cased _____ in., _____ ft.

Rig up _____

Sand _____

Drilling and Remarks:

Gas _____

10" @ 417

Oil _____

7" @ 2370

Total Depth 2627

289' 95" liner

PRODUCTION

1st 24 hrs. Nat. _____

1st 24 hrs. after shot _____

27,275,000

Gas _____ Cu. Ft.

Dry Hole _____

Cu. ft gas per day

Abandoned _____

Date

OVER

JUN 7 1950

19

J. E. TYRA Scout