


Section 15 Township 27 Range 35 WWell No. # 1 A. E. AlexandriaCompany Columbian Fuel

NORTH

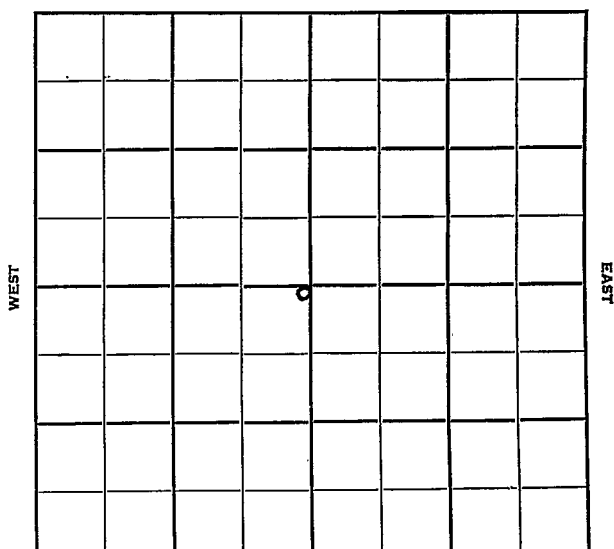

SOUTH

Grant

KANSAS

Sec. 15 Twp. 27 R. 35W

Well No. #1 A. E. Alexandria Farm

Columbian Fuel Company

Hugoton Pool Contractor


100' Ft. from N. Line

Ft. from S. Line

100' Ft. from E. Line

Ft. from W. Line

NE SW

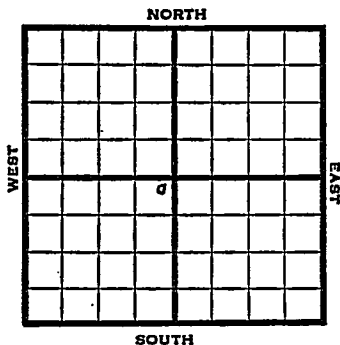

1951 Elev. 3074' REPORT

3/21 Location

5/16 Spud 4-2-51
Gas Well TD 2800
10" @ 600' 7" @ 2585
TD 2800
Hol. 2536' Her. 2604'
Krider 2625' Win. 2666'
Ft. Riley 2714'
16,000 A Comp. 11,668,000 gas 400#

COMPLETED

Kansas

Sec. 15 (S. 15) Twp. 27 (S. 27) Rge. 35W Map No.

Operator **Columbian Fuel**

Well No. 1 Farm A. E. Alexandria

Elev.	3388	Location	NE SW
-------	------	----------	-------

FIRST REPORT

100 Ft. From N Line SW

100 Ft. From E Line Quarter

1st. Report MAR 21 1951

Completion

Remarks


Spudding Date

Drig. Data	Hugoton Pool

Location

J. E. TYRA

County Grant State Kansas
 Sec. 15 (Blk. 27 (Sur. 35W Map No.
 Operator Columbian Fuel
 Well No. 1 Farm A. E. Alexandria
 Elev. 3074 Location NE SW

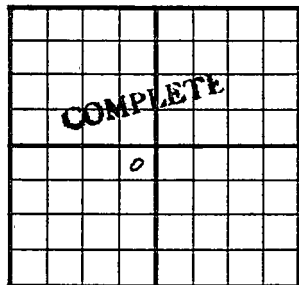

100 Ft. From N Line SW
100 Ft. From E Line Quarter
 1st. Report
 Completion MAY 16 1951
 Remarks Hugoton Pool

Spudding Date 4-2-51

Drlg. Data Gas well TD 2800
10" @ 600 7" @ 2585 TD 2800
Hol. 2536 Her. 2604 Krider 2625
Win. 2666 Ft. Riley 2714 16000 A
Comp. 11,668,000 gas 400 #

J. E. TYRA