

Kongman

Map No. _____ Sec. *15* Twp. *27* R. *7W*

Well No. *1* *Herman* Farm


J.B. Slick Company

200 Ft. from N. Line

_____ Ft. from S. Line

_____ Ft. from E. Line

200 Ft. from W. Line

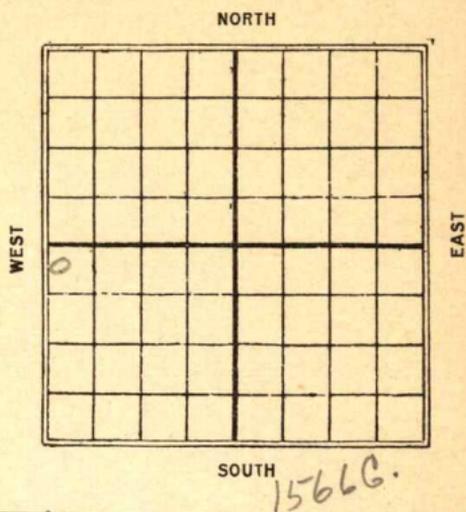

Date	1566 G	REPORT
<i>2/10</i>	<i>King Bldg</i>	
<i>4/7</i>	<i>Set 6" at 3175, V.A.</i>	
<i>4/29</i>	<i>Dlg 3380</i>	<i>3866</i> <i>31566</i> <i>2302</i>
<i>5/5</i>	<i>" 3500</i>	
<i>5/12</i>	<i>" 3527'</i>	
<i>5/21</i>	<i>Set 5" 3825' Dlg 3840 (2el)</i>	
<i>5/22</i>	<i>Dlg 3855 (2el) in shale.</i>	
<i>5/23</i>	<i>Gas show 3868-70</i>	
	<i>Show oil 3875-90</i>	
	<i>T.D. 3892 S.D. for orders (2el)</i>	<i>4213</i> <i>1566</i> <i>2642</i>
<i>5/24</i>	<i>Show Gas 3868-70</i>	
	<i>Show oil 3875-90</i>	
	<i>H.F.W. 3912 T.D. This well offsets</i>	
	<i>Fluegas well (2el)</i>	
<i>5/26</i>	<i>Top line 3868, Gas 3868 to 70</i>	
	<i>3875-90 show oil & water 3903-07</i>	
	<i>sand water T.D. 3912 H.F.W.</i>	
	<i>are going to wilcox</i>	
<i>6/2</i>	<i>Sands 3940 H.F.W. Donly 3954</i>	
<i>6/9</i>	<i>Donly 3970</i>	
	<i>(over)</i>	

6/18 - Top Wilcox 4213 T.D. 421
Plugging (see)

6/23 - D. & A. 4215'

3940
1526

2394

Map No. Sec. 15 Twp. 27 R. 7N

Well No. 1 Herman

T. B. Slick Company

Contractor

SECTION PLAT

200 Ft. from N. Line

----- Ft. from S. Line

----- Ft. from E. Line

200 Ft. from W. Line

0			

ABANDONED

Location -----

Rig up -----

Drilling and Remarks:

TID 4215

D & A.

RECORD

Cased ----- in., ----- ft.

Sand -----

Gas -----

Oil -----

Total Depth -----

PRODUCTION

1st 24 hrs. Nat. -----

1st 24 hrs. after shot -----

Gas ----- Cu. Ft.

Dry Hole -----

Abandoned -----

Date

JUN 23 1926

S. J. LEWIS

Scout

Map
KANSAS

Map No. *C* Sec. *15* Twp. *27* R. *7 W*

Well No. *1 Herman*

T. B. Blick Company

Contractor

SECTION PLAT

200 Ft. from N. Line

_____ Ft. from S. Line

_____ Ft. from E. Line

200 Ft. from W. Line

0			

FIRST REPORTS

Location _____

Rig up _____

Drilling and Remarks:

Rig Blidg

RECORD

Cased _____ in., _____ ft.

Sand _____

Gas _____

Oil _____

Total Depth _____

PRODUCTION

1st 24 hrs. Nat. _____

1st 24 hrs. after shot _____

Gas _____ Cu. Ft.

Dry Hole _____

Abandoned _____

Date

FEB 10 1926

S. J. LEWIS

Scout

MAP NO. _____ SEC. 15 TWP. 27S R. 7W

WELL NO. 1 Herman
T. B. Shick COMPANY _____

No well info

CONTRACTOR _____

SECTION PLAT

0			

_____ FT. FROM N. LINE

_____ FT. FROM S. LINE

_____ FT. FROM E. LINE

_____ FT. FROM W. LINE

RECORD

LOCATION _____

CASED _____ IN., _____ FT.

RIG UP _____

SAND _____

DRILLING AND REMARKS:

GAS _____

*4213-15
H. Z. H*

OIL _____

TOTAL DEPTH 4215

PRODUCTION

1ST 24 HRS. NAT. _____

1ST 24 HRS. AFTER SHOT _____

GAS _____ CU. FT.

DRY HOLE

ABANDONED

DATE

6/17 192 6

SCOUT