


Sedgewick KANSAS

DX 78-1

Section 15 Township 27 Range 1W
Well No. 1 Vanderhoff
Company A. D. Allison

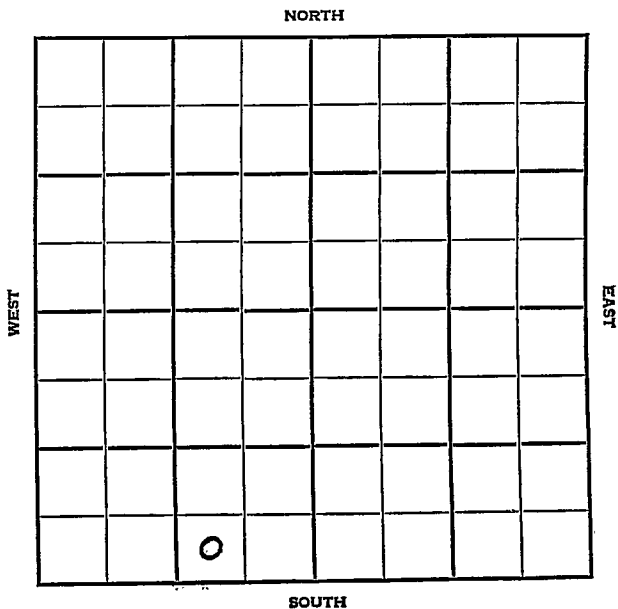

Sedgwick KANSAS

SEC.	TWP.	R.
15	27	1 W

WELL NO.

1 Vanderhoff

FARM

COMPANY

A. D. Allison

CONTRACTOR

Uhl

Hohn Pool


_____ Ft. from N. Line

330 _____ Ft. from S. Line

990 _____ Ft. from E. Line

_____ Ft. from W. Line

SW SE SW

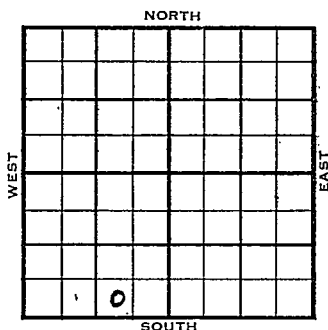

1954

ELEVATION
1311'

REPORT

8/4

Spud 8-2-54
8" @ 200 WOC

9/8

Spud 8-2-54
D & A
TD 3551'
8" @ 200'
KC 2640', Miss 3184', Simp 3526'
TD 3551'
DST 2768'-2805' opn 1hr 'rec 40' Mud
733#
DST 3171'-78' opn 1 hr, rec 30' Mud
128#
DST 3178'-88' opn 1½ hr, rec 30' ocm
150' sw 935#
D & A

ABANDONED

