


Section 15 Township 27 Range 1W

Well No. 1 Wilbur

Company Allison

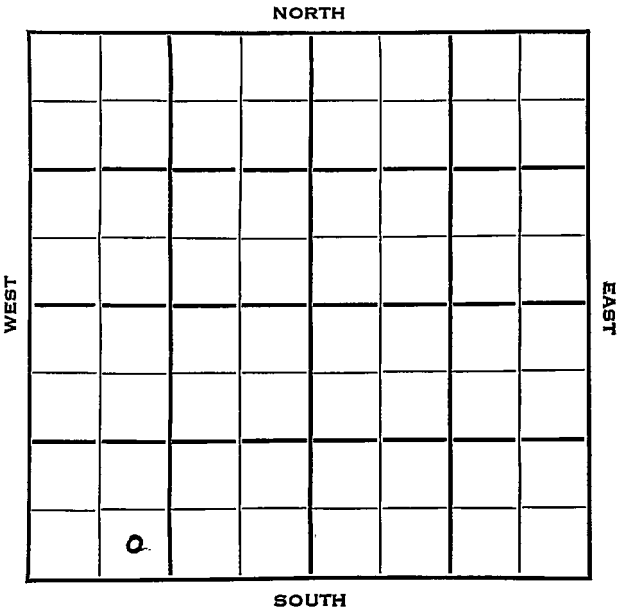

KANSAS

COMPANY _____ FARM _____

CONTRACTOR


Hohn Pool

330 Ft. from S. Line

Ft. from E. Line


990 Ft. from W. Line

SE SW SW

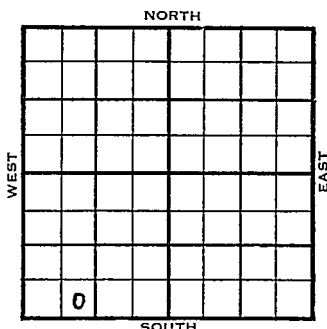

ELEVATION		REPORT
1954	1315'	
5/5	Spud 5-1-54 8" @ 162	WOC
5/19	Drlg 2460'	
5/26	RTD 3200' 5" @ 3190', WOCT	
6/2	WOCT	
6/9	KC 2641', Miss 3186' CO 2830' 24/2794-2802, 6/2804-06, SO & lot wtr SP 2830 DOC, SP 2770# 12/2755-59 wtr, DOC	
6/15	Spud 5-1-54 Oil well TD 3200 8" @ 162 KC 2641' Miss 3186' TD 3200 5" @ 3190 CO to 2830 24/2794-2802 6/2804-06 SO & wtr. P 2830 SP 2770 12/2755-59 wtr. B/2 BOPH Comp. 20 BOPD	

COMPLETED

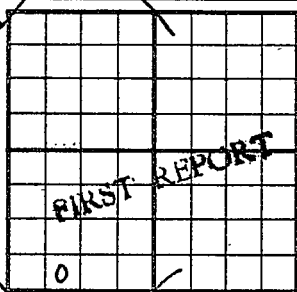
County **Sedgwick** State **Kansas**Sec. **15** (Blk. Twp.) **27** (Sur. Rge.) **1W** Map No.Operator **Allison**Well No. **1** Farm **Wilbur**Elev. Location **SE SW SW**330 Ft. From **S** Line **SW**990 Ft. From **W** Line Quarter1st. Report **MAY 5 1954**

Completion

Remarks

Salina Drlg. - Contr.Spudding Date **5-1-54**Drlg. Data **Hohn Pool****8" @ 162 WOC**

J. G. McGEHEE

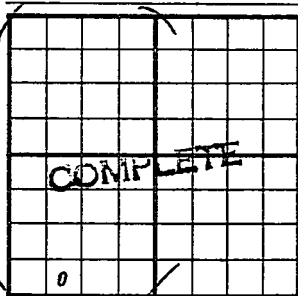County Sedgwick State KansasSec. 15 (Blk.
Twp.) 27 (Sur.
Rge.) 1W Map No.Operator AllisonWell No. 1 Farm WilburElev. 1315 Location SE SW SW330 Ft. From S Line SW990 Ft. From W Line Quarter

1st. Report

Completion JUN 15 1954Remarks Hohn PoolSalina Drlg. - Contr.Spudding Date 5-1-54Drlg. Data Oil well TD 32008" @ 162 KC 2641 Miss. 3186TD 3200 5" @ 3190 CO to 283024/ 2794-2802 6/ 2804-06 SO & wtr.SP 2830 SP 2770 12/ 2755-59 wtr.B/ 2 boph Comp. 20 bopd