


DX 78-1

Section 25 Township 27 Range 16W

Well No. 1 Clarkson

Aurora Gas

Company _____

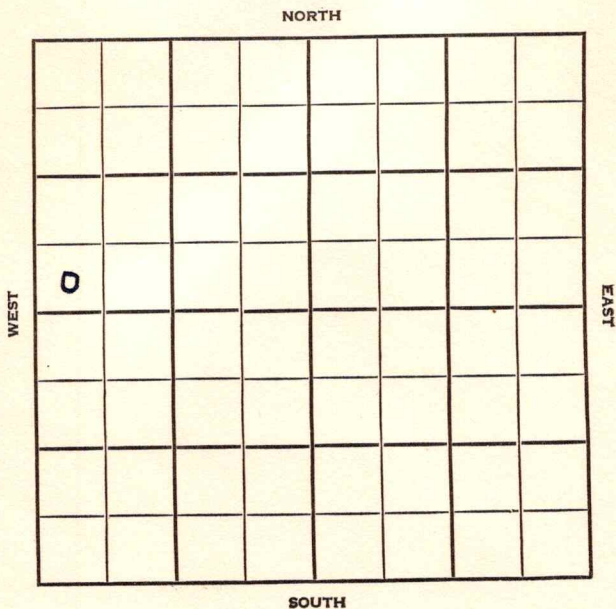

Kiowa

KANSAS


SEC.	TWP.	R.
25	27	16 W

WELL NO. _____
 # 1 Clarkson FARM
 COMPANY _____

Aurora Gas
 CONTRACTOR _____

Anschutz

_____ Ft. from N. Line
 330 _____ Ft. from S. Line
 _____ Ft. from E. Line
 330 _____ Ft. from W. Line

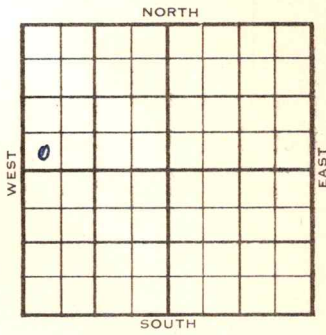

SW SW NW

Phillips - DHM

1954	ELEVATION 2095'	REPORT
------	--------------------	--------

8/4 Location

9/15 Spud 8-6-54
 D & A
 TD 4950'
 8-5/8" @ 978'
 Anhy 976', Br. Lime 4079', KC 4095'
 B KC 4407', Cherokee 4565',
 DST 4565'-77' opn 1 hr, 2100' gas, 60'
 O & GCM, 180' oil, 900#
 DST 4600'-07' opn 1 hr, rec 15' Mud
 DST 4608'-25' opn 1 hr, rec 60' vsocm
 O# Kh. 4633', Viola 4709',
 DST 4170'-35' opn 1 hr, rec 30'
 mud, 850# Simp 4816', Arb 4912'
 TD 4950'
 5" @ 4720'
 Schlumberger Tops: Heeb 3918', Br.
 Lime 4075', Lans 4095', Miss 4592',
 Viola 4708', Simp 4812', Simp Sd. 4858'
 Arb. 4908'
 TD 4950'
 D & A

ABANDONED

Drig. Data

Simp. 4812 Simp. 4858

Arb. 4908 TD 4900

D & A

SEP 22 1954

