

Kiowa


KANSAS

SECTION 27 TOWNSHIP 27S RANGE 16W

WELL NO. #1 Rothmeir

COMPANY Walters Drlg.

NORTH C NE NW

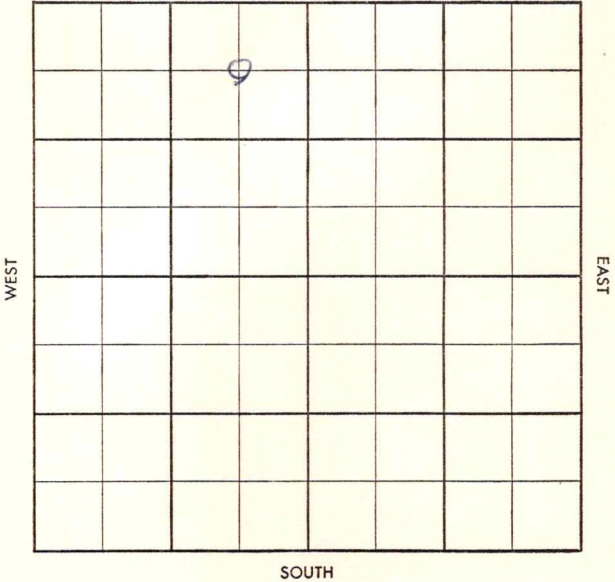



S-513-B

County Kiowa Elev. 20900F 2013FB
 Sec. 27 Twp. 27 Rge. 16W
 Company Walters Drlg.
 Farm Name Pathmeir No. 1

	TOPS	DEPTH	LOG	DATUM
Anh.				
Tp.				
H.		3906	3906	
Tr.				
Dg.		3922		
B.L.		4062	4064	
L.		4078	4081	
K.C.				
B.K.C.			4398	
Ce.		4567		
C.				
M.		4592	4585	
M.				
K. <u>sd</u>		4675	4673	
Mz.				
Mq.				
V.		4716	4696	
S.				
S.				
A.				
R.				
Pf.				
G.				
T.D.		4732		

Loc. in Sec. C NE NW
 Geol. _____
 Contr. Honaker-Davis
 Pool Wildcat

6

ABANDONED

SEP 10 '58

Date Comm. 7-15-58 NCPA DHM
8" @ 315 WOC JUL 23 '58 ϕ 2097 JUL 30 '58

DST 4595 - 4615 1hr g/17" ga 76mcf
 90' gem FP 48 - 60 BHP 1533/20
 - 1440/30" DST 4594 - 4645 1hr
 g/25" ga 62mcf 170' gem FP 78-105
 BHP 1230/20 - 1365/30" ran log
 AUG 5 '58 $4\frac{1}{2}$ 4731/200 AUG 13 '58 CO
 90/4604 - 24 NS 750A \$6F10
 Ld frac F10 T49780 NW
~~Notes~~

F10 1.8 330 ph NW FCP 260

ga 1.000 muf 7 hrs

51 TP 1315 SICP 1325 AUG 20 '58

F10 1830 NW ga 1.500 MCF

8 hrs 1/2 chkt CP 209 F10


21.6 BF 1090 W 24 hrs 3/4 chkt

CP 190 TP 40 AUG 27 '58

F 11.7 BF (6% W) 13 ~~hr~~ hr.

CP 210 # TP 90 # SEP 3 '58

SEP 10 '58 F10 5.0 BF 4090 W 13 hrs

D6A 

27-27-16W

CNE NW

~~Twohanna Pool~~

WILDCAT

S-513-B

County Kiowa Elev. _____
 Sec. 27 Twp. 27 Rge. 16W
 Company Walters Drlg.
 Farm Name Rothmeir No. 1

TOPS	DEPTH	LOG	DATUM
Anh.			
Tp.			
H.			
Tr.			
Dg.			
B.L.			
L.			
K.C.			
B.K.C.			
Ce.			
C.			
M.			
M.			
K.			
Mz.			
Mq.			
V.			
S.			
S.			
A.			
R.			
Pf.			
G.			
T.D.			

Loc. in Sec. C NE NW

Geol. _____

Contr. Honaker-Davis

Pool Wildcat



Date Comm. 7-15-58
8" @ 315 WOC

Co

Li

No.

Sec.

T.

R.