

Kiowa

KANSAS

SECTION 4 TOWNSHIP 27S RANGE 16W

WELL NO. #1 Lily French


COMPANY Falcon-Seaboard & Sunray Mid-Continent

NORTH

C NE SW

WEST

EAST

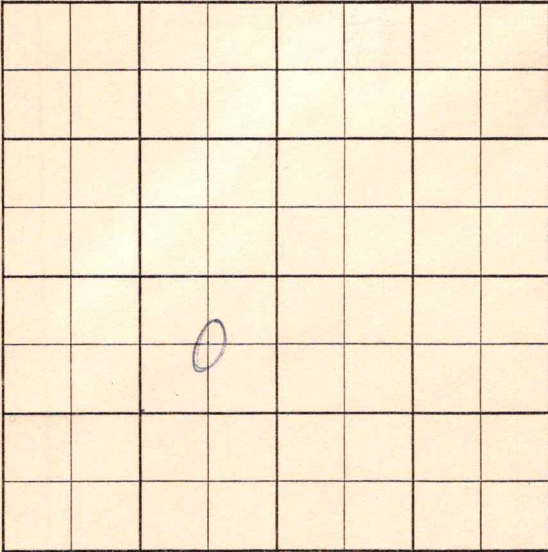

SOUTH

HOT FILE		Kiowa	KANSAS
SEC.	TWP.	R.	
4	27 S	16 W	

WELL NO.

1 Lily French

FARM

COMPANY

Sunray Mid-Continent (DEVELOPMENT)

CONTRACTOR

Falcon-Seaboard

Kirk & Trousdale Fld. Area (WC)

660 FT. FROM N. LINE


FT. FROM S. LINE

660 FT. FROM E. LINE

FT. FROM W. LINE

of SW/4

C NE SW

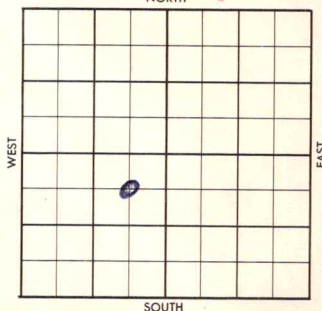

ELEVATION

REPORT

1957

4600' Viola Test

12/20

MIRT

(DR#247)

12/23

Spudded 12-22-57

TD 428'. WOC. 8-5/8" @ 428'

12/24

TD 428'. WOC. 8-5/8" csg.

12/26

Drlg. 1333'

(FR Tkt)

12/27

Drlg. 2278'

12/30

Drlg. 3320'

12/31

Drlg. 3693'

1958

1/2

Drlg. 4220'

1/3

Drlg. 4380'

1/6

Drlg. 4596'

1/7

TD 4700'. Rng. EL.

1/8

TD 4700'. WOC. 5 1/2" @ 4694'

1/9

TD 4700'. WOC. 5 1/2" csg.

1/10

TD 4700' MICT

1/13

TD 4700'. Testing perfs 4525-4558'

1/14

TD 4700'. Swbg. load oil. "

1/15

TD 4700'. Testing perfs "

1/16

" " "

1/17

TD 4700'. Flowed 150 BO 24 hrs.

Perfs 4525-4558' Viola Zone.

Complete

(DR#12-1958)

WILDCAT

FIRST	REPORT	3
-------	--------	---

9

DEC 26 1957

Sunray Mid-Continent

X

USE

No.

SEC.

TWP

RGF

C. & P.

1	2	
---	---	---	---	---	---	---	---	---	----	----	-----

CO. Kiowa ELEV. 2102 RB
 SEC. 4 TWP. 27 RGE. 16W COMPLETE
 Falcon-Seaboard No. 1
Sunray Mid-Continent
 FARM Lily French
 LOC. C NE SW

FEB 12 '58

BL 4010
 Lsg 4023
 BKC 4296
 Marm 4338
 CeSD 4482
 M 4495
 Ksd 4524
 UID 4663
 TD 4700

GEOL.

CONTR. Falcon-Seaboard
Trousdale 50

POOL

SPUD 12-22-57

C. & P. JAN 2 '58 85"

428/425 Ø 3693

JAN 9 '58 TOPS DST

4474-4502 60" GB

120' gip rec 14" M

BHP 420/30" TOPS

DST 4521-39 60" GB rec 30'

M BHP 235/30" end 4539-79

rec 40' (33' sd sat bleeding

oil & gas 5' 5dy shale No show

2' shale Ø 4602 x 5 1/2" x 4694 x

woc N test in end JAN 15 '58 X

CO 4605 black sq. 4587-88

4505-06 CO 4575 66/4525-58

seum oil 4 hrs 500 mch + 16 gal

fracture frac 20,000 x 20,000

~~\$12 hr. test for oil~~
 \$409 BLD 12 hrs

Lack 311 B of Ld JAN 22 '58 F10

thru 14/64" chk 5 Boph NW

ga 1.938 mcf CP 980 TP

675 rec all Ld F10 4 Boph

2.000 mcf CP 980 TP 675

14/64" chk F10 150 Boph +

ga 1,762 mcf 24 hrs

thru 14/64" chk CP 920

TP 600 GOR 11,750:1

S1 to install surface equip

JAN 29 '58 S1 7 Days SICP 1300

S1 TP 1285 F10 5.4 Boph

thru 16/64" chk 3 hrs

TP 1035 CP 1240 + ga 654 mcf

F10 6.5 Boph thru 20/64" chk

3 hrs TP 900 CP 11.50 +

ga 1.938 mcf F10 9.6

Boph thru 24/64" chk 3 hrs

TP 720 CP 1040 + ga 2.146 mcf

gravity 3.5.20 S1 totst

FEB 5 '58 X F10 4 Boph + 6 Boph

+ thru 17/64" chk NT + ga

960 mcf TP 1025 CP 10.50

F10 48 Boph + 44 BW 24 hrs

TP 630 CP 960 + ga 960 mcf

complete S1 gas well FEB 12 '58