

Section 16 Township 27 Range 38W

Well No. 1 Ackerman


Company Western Natural Gas

Hugoton

NORTH

WEST

EAST

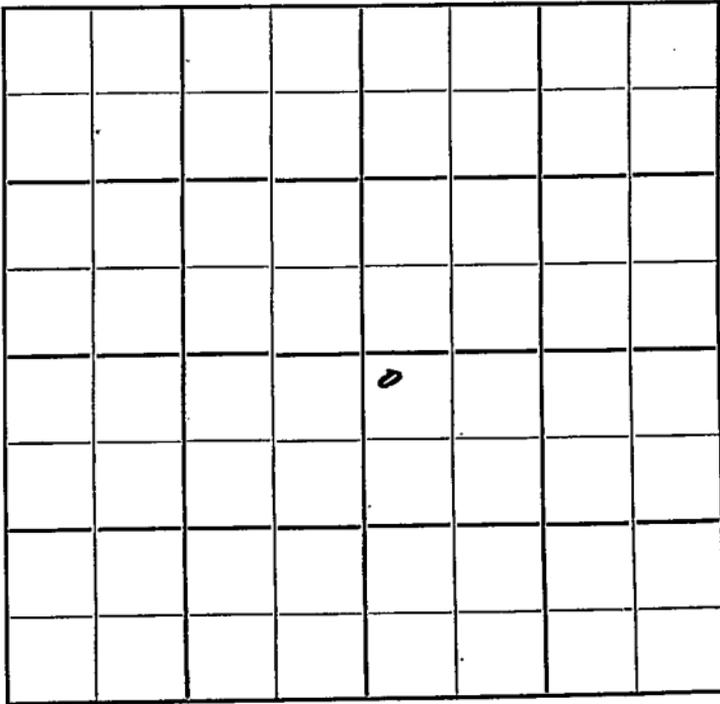

SOUTH

Sec. 16 Twp. 27 R. 38W ✓

Well No. #1 Ackerman Farm
Western Natural Gas


Hugoton Pool (Livermore, Cont.) Company

150' Ft. from N. Line

_____ Ft. from S. Line

_____ Ft. from E. Line

150' Ft. from W. Line

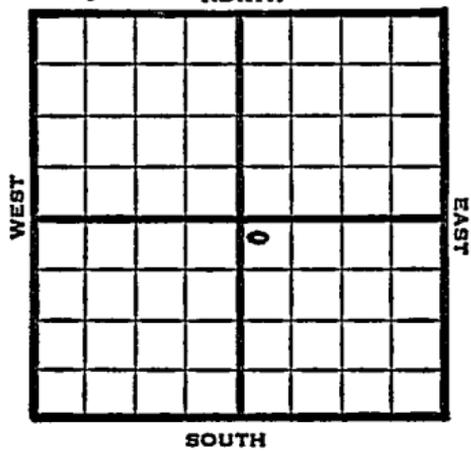

NW SE

1949

Elev 3156'

REPORT

8/10

10" @ 584'
Drlg. 2060'

8/16

"

8/24

7" @ 2463
Drlg. 2588'

8/31

TD 2588'
7" @ 2463'
241' of 5" Perf Liner @ 2588'
7,050,000 Gas
417# R PR.
Comp

COMPLETED

Kansas

Map No. _____ Sec. 16 Twp. 27 R. 38W

Well No. 1 Ackerman

Western Natural Gas Company

Livermore Contractor

NW SE

FIRST REPORT
SECTION PLAT

150 Ft. from N. Line

_____ Ft. from S. Line

_____ Ft. from E. Line

150 Ft. from W. Line

		0	

Grant County

Location _____

Rig up _____

Drilling and Remarks:

10" @ 584
drlg. 2060

RECORD

Cased _____ in., _____ ft.

Sand _____

Gas _____

Oil _____

Total Depth _____

PRODUCTION

1st 24 hrs. Nat. _____

1st 24 hrs. after shot _____

Gas _____ Cu. Ft.

Dry Hole _____

Abandoned _____

Date

AUG 10 1949 19

S. J. LEWIS Scout

Map No. 1 Sec. 16 Twp. 27 R. 38WWell No. I Ackerman

Western Natural Gas Company

COMPLETE


Contractor

NW SE

E1.3156
SECTION PLAT150 Ft. from N. Line

Ft. from S. Line

Ft. from E. Line

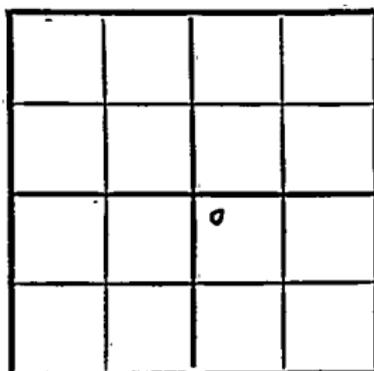150 Ft. from W. Line

Grant County

Location

Rig up

Drilling and Remarks:

7" @ 2468241' of 5" Prof line@ 25787,000,000 Gall417° RA

RECORD

Cased _____ in., _____ ft.

Sand _____

Gas _____

Oil _____

Total Depth 2578

PRODUCTION

1st 24 hrs. Nat. _____

1st 24 hrs. after shot _____

Gas _____ Cu. Ft.

Dry Hole _____

Abandoned _____

Date

AUG 31 1949

S. J. LEWIS Scout