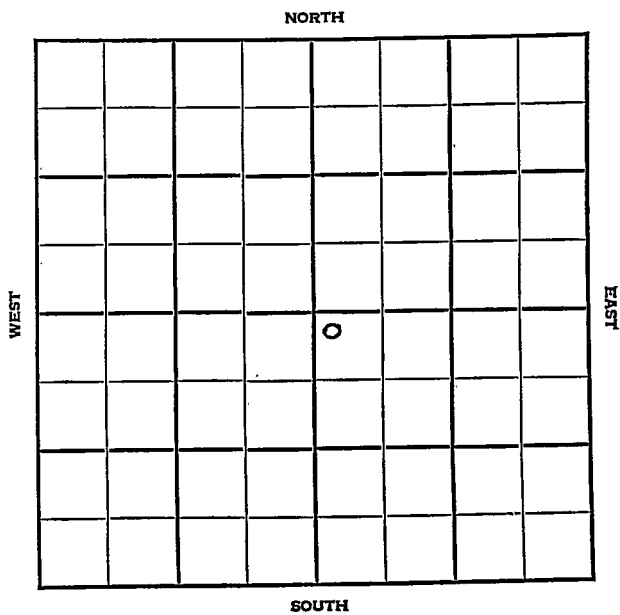


Section 16 Township 27 Range 36-WWell No. #1 Hoffman "B"Company Columbian Fuel

Grant

Sec. 16 KANSAS Twp. 27 R. 36W

Well No. #1 Hoffman "B" Farm

Columbian Fuel Company

Hugoton Pool


100' Ft. from N. Line

 Ft. from S. Line

 Ft. from E. Line

100' Ft. from W. Line

NW SE

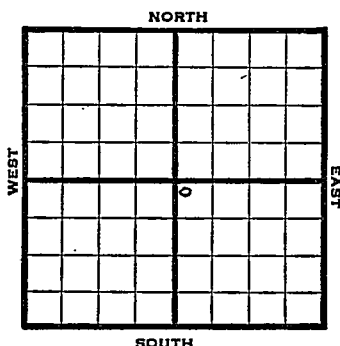

1946

Elev. 3126'

R E P O R T

5/5

10" @ 560'

Drlg. 2300'

5/12

"

5/19

TD 2696'

189' of 5" Perf liner @ 2696

5/26

7" @ 2517'

189' of 5" Perf liner @ 2696'

Acid 15,000

Gas 31,785,000

R. Pr. 425#

TD 2696'

COMPLETED

Map No. _____ Sec. 16 Twp. 27 R. 36W

Well No. 1 Hoffman "B"

Columbian Fuel Company

FIRST REPORT

Contractor _____

NW SE

SECTION PLAT

100 Ft. from N. Line

_____ Ft. from S. Line

_____ Ft. from E. Line

100 Ft. from W. Line

		o	

Grant County

Location _____

Rig up _____

Drilling and Remarks:

10" @ 560

drlg. 2300

RECORD

Cased _____ in., _____ ft.

Sand _____

Gas _____

Oil _____

Total Depth _____

PRODUCTION

1st 24 hrs. Nat. _____

1st 24 hrs. after shot _____

Gas _____ Cu. Ft.

Dry Hole _____

Abandoned _____

Date

MAY 5 1948

19

S. J. LEWIS

Scout

Map No. _____ Sec. 16 Twp. 27 R. 36W

Well No. 1 Hoffman "B"

Columbian Fuel Company

COMPLETE

Contractor

NW SE

E1.3126
SECTION PLAT

100 Ft. from N. Line

_____ Ft. from S. Line

_____ Ft. from E. Line

100 Ft. from W. Line

		0	

Grant County

Location _____

Rig up _____

Drilling and Remarks:

7" 02517
189' x 15" Prof. hole
C 2696
15000 ac. oil
31,785,000 Gas.
425" R.P.

RECORD

Cased _____ in., _____ ft.

Sand _____

Gas _____

Oil _____

Total Depth 2696

PRODUCTION

1st 24 hrs. Nat. _____

1st 24 hrs. after shot _____

Gas _____ Cu. Ft.

Dry Hole _____

Abandoned _____

Date

MAY 26 1948

19

S. J. LEWIS

Scout