


Section 16 Township 27 Range 39W

Well No. #1 Chadd Unit

Company Starolind

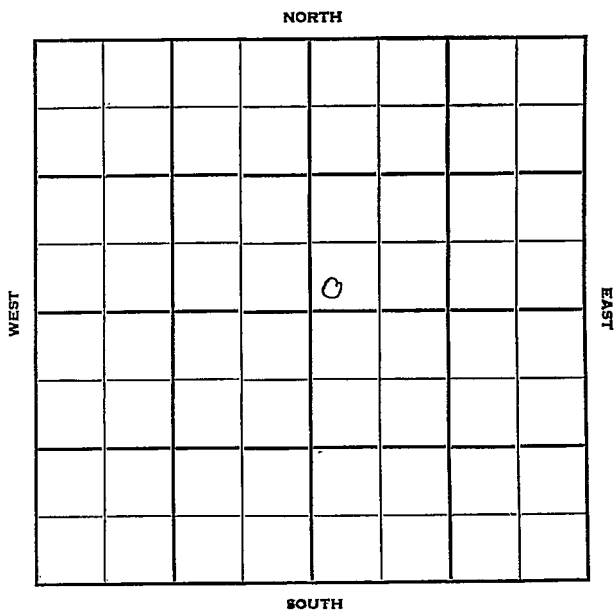

Sec. 16 Twp. 27 R. 39W ✓

Well No. #1 Chadd Unit Farm

Stanolind Company

Contractor


Ft. from N. Line

150' Ft. from S. Line

Ft. from E. Line

150' Ft. from W. Line

NORTH

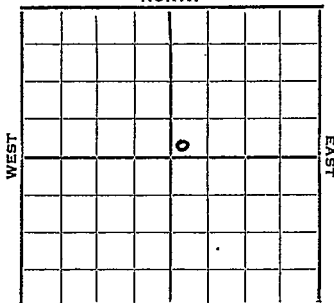

SOUTH

SW SW NE

1952 Elev. 3172' REPORT

3/26 Location
 4/1 10" @ 746'
 Drlg. 1725'
 4/9 RTD 2474 7" @ 2458' WOCT
 Hrt Krider 2282 Winfield 2338
 Up Ft 2399 Low Ft 2458
 4/23 Spud 3-29-52
 Gas Well TD 2483 10" @ 746'
 7" @ 2458' TD 2474
 Her. 2282 Win. 2338
 Ft. Riley 2399 DD 2483
 2500 A 12/ 2282-84 24/ 2286-90
 24/ 2302-96 30/ 2319-24
 30/ 2338-43 30/ 2350-55
 96/ 2367-78 48/ 2399-2407
 60/ 2413-23 18/ 2428-31
 24/ 2436-40 24/ 2448-92
 2000 A
 Comp. 9,521,000 gas

COMPLETED

