


Hingman

Form 51-5M-3-26-22544

Map No. *TRANS* Sec. *16* Twp. *27* R. *7W*

Well No. *2* *Richardson* Farm
Carter Oil Company

NORTH

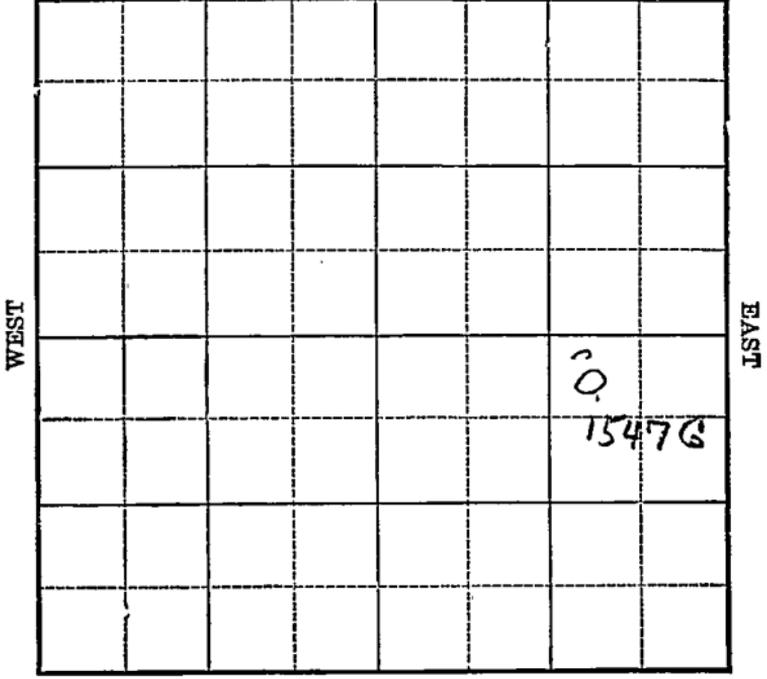

Location _____

Drilling Remarks _____

Rig Up _____

Drilling Remarks _____

RECORD

Cased _____ in. _____ ft.

Sand _____

Gas _____

Oil _____

Total Depth _____

PRODUCTION

1st 24 hrs. Nat. _____

1st 24 hrs. after shot _____

Gas _____ cu. ft.

Dry Hole _____

Abandoned _____


Map No. Kansas Sec. 16 Twp. 27 R. 7 ^W
 Well No. 2 Richardson Farm
Carter Oil Company

330 Ft. from N. Line

..... Ft. from S. Line

990 Ft. from E. Line

..... Ft. from W. Line

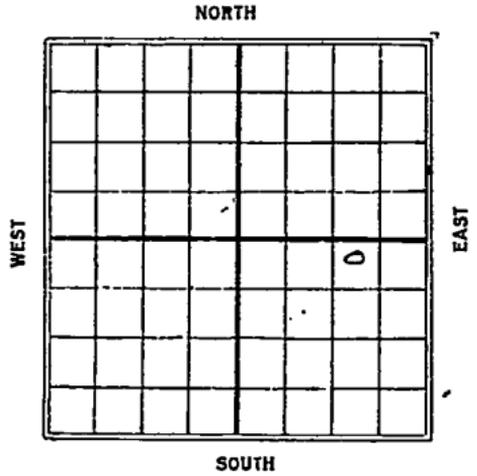

Date 15th 1926 76 ⁷⁵ REPORT

7/9	Location		
7/22	Rigging up		
7/28	Spud	220	
8/4	Dlg	960	
8/11	"	1740	
8/18	"	1865	$\frac{15 \frac{1}{2}}{1 \frac{1}{2}} \times 5$
8/25	"	2340	$\frac{1 \frac{1}{2}}{2}$
9/1	"	2668	
9/8	"	3100	
9/15	"	3170	
9/22	"	3225	
9/29	"	3332	
10/6	"	3420	
10/13	J.D.	3610	W.P. 6"
10/20	J.D.	3610	fishing barrel
10/27	J.D.	3615	W.P. 6" csg.
11/3	Dlg	3685	
11/9	Top chok	3832	Gas 3826
	Connecting up	(see)	
11/10	Gas	3836	2 m gas
	work at	3837	
11/17	J.D.	3854	Cem 5"

- 11/24 - S.D. for Cement & to set
12/1 - T.D. 3854 - Drlg out
cement.
12/8 - Same
12/15 - _____
12/17 - Drilled Cement + Plug out little
spray oil + Gas. T.D. 3855 then
filled up with water. Will
drill to Wilcox if don't
make well (see)
12/20 - Set plug at 3854' drlg plug
had small show oil + gas
drlg. to 3855' filling up with
water at 3860' 1500' water intake
(tel)
12/21 - 3855 to 60 H.F.W.
Drlg 3865 in Chat.
12/29 - T.D. 3865 S.D. for Cem. to set.

1927

- 1/5 - Same
1/12 - T.D. 3905 - H.F.W. show oil
1/19 - Chat 3822 - 3904
T.D. 3908 H.F.W.

no ^{as} ~~as~~ **KANSAS** *Kingman Co*
 Map No. _____ Sec. *16* Twp. *27* R. *7 N*
 Well No. *2* *Richardson*
Carter Oil Co Company

Contractor

FIRST REPORTS

SECTION PLAT

336 Ft. from N. Line

_____ Ft. from S. Line

990 Ft. from E. Line

_____ Ft. from W. Line

			o

Location _____

Rig up _____

Drilling and Remarks:

*Carter have
 got 3 legs
 interest.*

RECORD

Cased _____ in., _____ ft.

Sand _____

Gas _____

Oil _____

Total Depth _____

PRODUCTION

1st 24 hrs. Nat. _____

1st 24 hrs. after shot _____

Gas _____ Cu. Ft.

Dry Hole _____

Abandoned _____

Date

JUL 9 1926

CHAS. L. SHERWOOD

192

Scout

ms Wall
map

Returned
Cards	<i>BB</i>
Tracing	<i>normal</i>
France Map
Scarborough Map	<i>BB</i>
Moody Map
Scarborough Plat Book
Moody Plat Book

Map No. KANSAS Sec. 16 Twp. 27 R. 7 N

Well No. 2 Richardson

Carter Oil Company

Contractor

SECTION PLAT

330 Ft. from N. Line

_____ Ft. from S. Line

990 Ft. from E. Line

_____ Ft. from W. Line

			0

FIRST REPORTS

Location _____

Rig up _____

Drilling and Remarks:

ROG

RECORD

Cased _____ in., _____ ft.

Sand _____

Gas _____

Oil _____

Total Depth _____

PRODUCTION

1st 24 hrs. Nat. _____

1st 24 hrs. after shot _____

Gas _____ Cu. Ft.

Dry Hole _____

Abandoned _____

Date

JUL 14 1926

S. J. LEWIS

Scout

original map

Returned	
Cards	<i>MPA</i>
Tracing	<i>1</i>
France Map	
Scarborough Map	<i>1</i>
Moody Map	
Scarborough Plat Book	
Moody Plat Book	

Map No. KANSAS Sec. 16 Twp. 27 R. 2W

Well No. 2 Richardson

Carter Oil Company

Contractor

SECTION PLAT

330 Ft. from N. Line

_____ Ft. from S. Line

990 Ft. from E. Line

_____ Ft. from W. Line

			0

ABANDONED

Location _____

Rig up _____

Drilling and Remarks:

Chas 3832 & 3904

T D 3908 HFW

D & A.

RECORD

Cased _____ in., _____ ft.

Sand _____

Gas _____

Oil _____

Total Depth _____

PRODUCTION

1st 24 hrs. Nat. _____

1st 24 hrs. after shot _____

Gas _____ Cu. Ft.

Dry Hole _____

Abandoned _____

Date

JAN 19 1927

192

1927
 S. J. LEWIS Scout
 1927

Returned	
Cards	<i>None</i>
Tracings	<i>None</i>
France Map	
Scarborough Map	<i>X</i>
Moody Map	
Scarborough Plat Book	
Moody Plat Book	

None
NO WALL MAP

MAP No. _____ SEC. 16 TWP. 77S R. 7W

WELL No. Richardson

Carter COMPANY

CONTRACTOR

SECTION PLAT

			0

_____ FT. FROM N. LINE

_____ FT. FROM S. LINE

_____ FT. FROM E. LINE

_____ FT. FROM W. LINE

LOCATION _____

RIG UP _____

DRILLING AND REMARKS:

RECORD

CASED _____ IN. _____ FT.

SAND _____

GAS _____

OIL _____

TOTAL DEPTH 3108

PRODUCTION

1ST 24 HRS. NAT. _____

1ST 24 HRS. AFTER SHOT _____

GAS _____ CU. FT.

DRY HOLE

ABANDONED

DATE

1/25 1927

SCOUT