


Section 16 Township 27 Range 7W

Well No. 2 Woolridge "A" (Wooldrige)

Company Heathman & Seeligson

NORTH

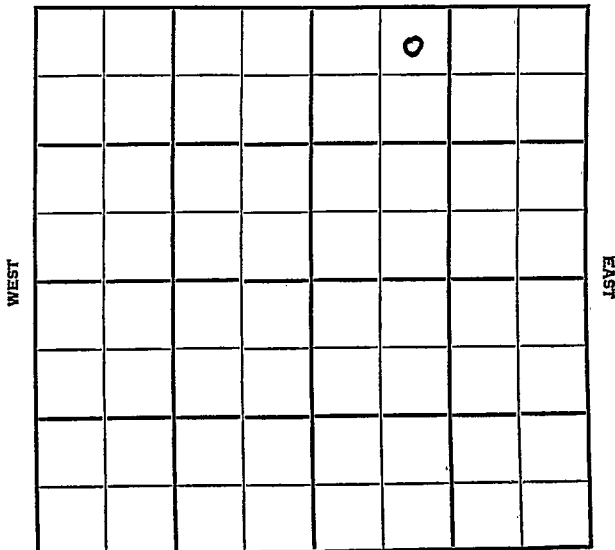

SOUTH

Kingman KANSAS

SEC.	TWP.	R.
16	27	7W

WELL NO. 2 Woolridge "A" FARM

COMPANY Heathman & Seeligson

CONTRACTOR Prime Drlg.


Woolridge Pool

330 Ft. from N. Line

Ft. from S. Line

Ft. from E. Line

990 Ft. from W. Line

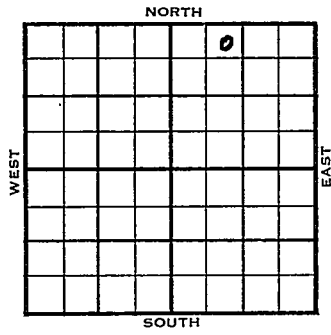

NE NW NE

	ELEVATION	REPORT
1955	1524'	

1/19 Spud 1-16-55
8" @ 182'
Drlg. 480'

3/9 Spud 1-16-55 - Oil Well
TD 3847'
8" @ 182'
Top 2999', Br lime 3097', Lans 3113',
Miss 3800'
DST 3817-22', opn 2 hrs., rec. 77'
gcm, 15' wtry mud, 1420#
DST 3822-27, opn 2 hrs., gas in 3",
1,250,000 cfg 5", rec. 365' oil, 1455#
~~XXXXXXXXXX~~
DST 4827-32, opn 2 hrs., rec.
1,250,000 cfg, 330' oil, 1425#
DST 3832-37', gas in 5", rec. 44,000
cfg, 800' oil, 150' mo, 1425#
DST 3837-42, opn 2 hrs., gas in 10",
F/oil 1 hr., 1440#
DST 3842-47, opn 2 hrs., rec. 110'
o&gcm, 0#
TD 3847'
5" @ 3847'
CO 32/3835-39, 250 M-A
F/6.68 boph 1 hr.
Comp. F/239 bopd

