

KANSAS Sedgwich


Section 16 Township 27 Range ~~24~~ 1W

Well No. 1 Willbur

Company Drillers Gas

(Hahn Pool)

Hahn Pool NORTH

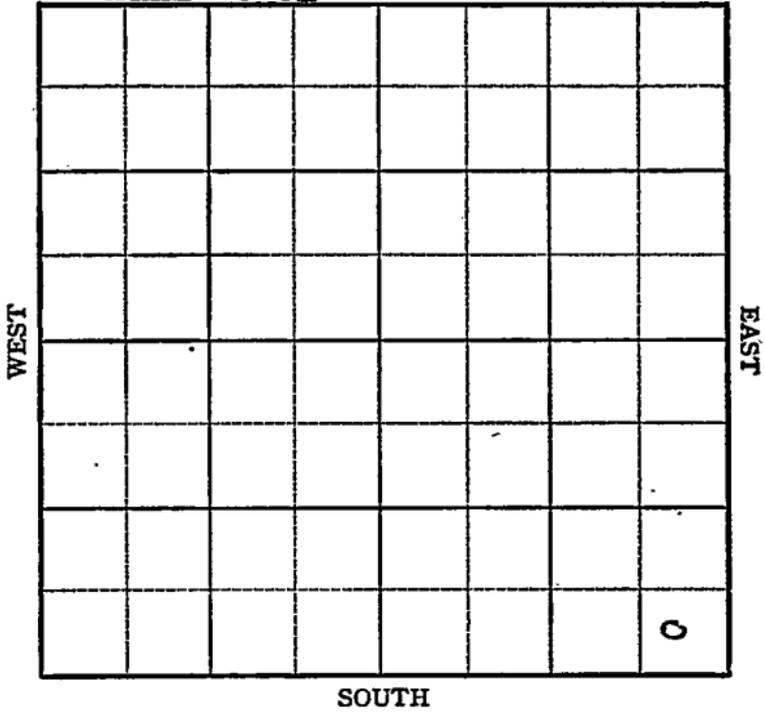

**KANSAS**

Sedgwick



Sec. 16 Twp. 27 R. 1W

Well No. #1 Willbur Farm

Drillers Gas Company

**Hahn Pool**


\_\_\_\_\_ Ft. from N. Line

330' Ft. from S. Line

330' Ft. from E. Line

\_\_\_\_\_ Ft. from W. Line

SE/C

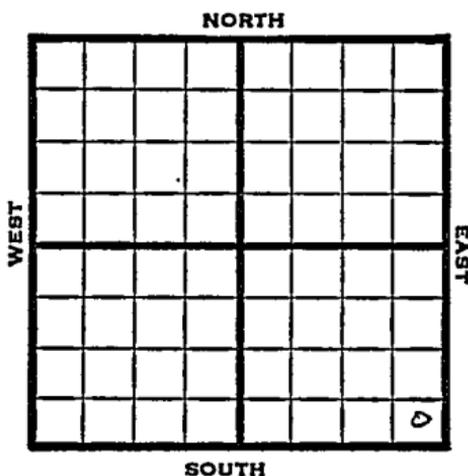

1949

**REPORT**

3/2  
3/8  
3/16

RUR  
10" @ 156'  
Drlg 1620'  
TD 3233'  
Miss 3227'  
Aband.

**ABANDONED**

Map No. \_\_\_\_\_ Sec. 16 Twp. 27 R. 1W

Well No. 1 Willbur

Drillers Gas Company

FIRST REPORT

Contractor

SE/C

SECTION PLAT

\_\_\_\_\_ Ft. from N. Line

330 Ft. from S. Line

330 Ft. from E. Line

\_\_\_\_\_ Ft. from W. Line


Sedgwick County

Location \_\_\_\_\_

Rig up \_\_\_\_\_

Drilling and Remarks:

R U R

RECORD

Cased \_\_\_\_\_ in., \_\_\_\_\_ ft.

Sand \_\_\_\_\_

Gas \_\_\_\_\_

Oil \_\_\_\_\_

Total Depth \_\_\_\_\_

PRODUCTION

1st 24 hrs. Nat. \_\_\_\_\_

1st 24 hrs. after shot \_\_\_\_\_

Gas \_\_\_\_\_ Cu. Ft.

Dry Hole \_\_\_\_\_

Abandoned \_\_\_\_\_

Date

MAR 2 1949 19

S. J. LEWIS Scout

