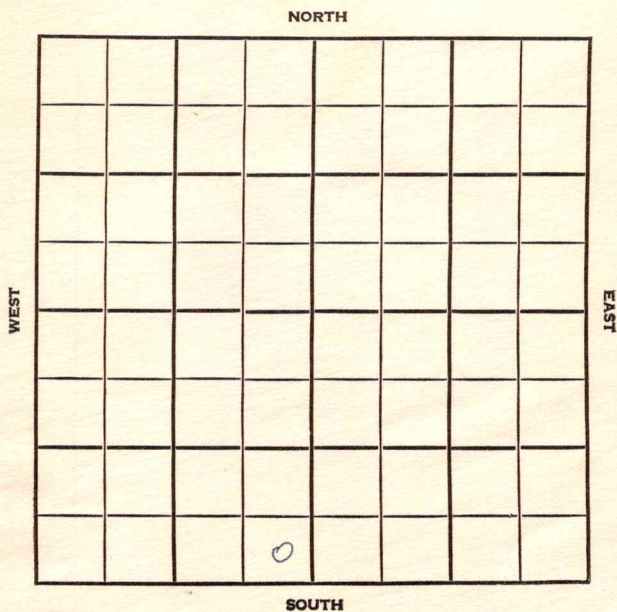


Section 17 Township 27S Range 17WWell No. #1 CampbellCompany Aurora Gasoline Co

17 27 S 17 W

WELL NO. # 1 Campbell FARM

COMPANY Aurora Gasoline Co.

CONTRACTOR

Smitherman


Wildcat

FT. FROM N. LINE

FT. FROM S. LINE

FT. FROM E. LINE

FT. FROM W. LINE

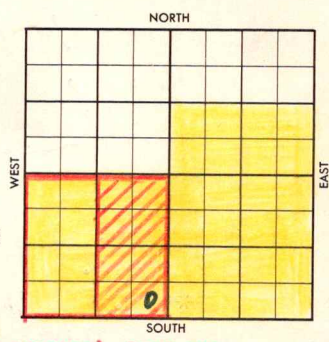

SE SE SW

Amerada-DHM Ted Gore-DHM

SDX - DHC \$3500.00 (Lse S-30303) -SDX-FO

1956 ELEVATION 2142' Gr. 2145' REPORT 2147' KB(TWH6-DC7)

7/6 Arbuckle Lime Test appx 5050'
To commence by Aug. 1, 1956
To complete by Sept. 1, 1956.
(See DHC Agreement)

8/28 Time Extension given by SDX:
To commence by Sept. 1, 1956
To complete by Oct. 1, 1956
(See letter of extension 8/24/45)
Arbuckle Test

8/29 Location (FR Ticket)

9/1 Cellar & Pits. (Card-Aurora Gaso)

9/5 MIRT "

9/7 Spud 9-7-56 "

9/10 8-5/8" @ 382 w/400 sax. "

9/11 Drlg. 1877' "

9/12 Drlg. 2400' "

9/13 Drlg. 2661' "

9/14 Drlg. 2915' "

9/15 Drlg. 3212' "

9/16 Drlg. 4025' "

9/18 Heeb 3956, Brn Ls 4105', Lans. 4121'
Drlg. 4212' (Card-Aurora Gas.)

9/19 DST #1, 4268-86, open 1 hr, very
weak blow 9 mins, rec 45' muddy wtr.
IBHP 1525# 20". FBHP 1500# 20"
IFP 45# FFP 65#. Drlg. 4316'
(Card-Aurora Gas)

OVER

1956

9/20

Base Kansas City 4448'

Making trip @ 4469' (Card-Aurora Gas)

9/21

Cherokee shale 4607

Making trip @ 4640' "

9/24

Miss 4669' Khk sd 4758'

Viola ?? 4799'

DST #2, 4654-95, open 1 hr, gas
in 5", Ga/1,200,000 CF 10 mins,
1,250,000 CFG 20", 1.2 MCFG last 30
mins, rec 360' GCM. FP 245-300#.

BHP 1290# 30"

DST #3, 4698-4730', open 1 hr,
gas in 36", Ga/44,000 CFG, rec 95'
GCM. FP 50-60#. IBHP 1545#. FBHP 1565#

Drlg. 4897' (Card-Aurora Gasoline)

9/25

Drlg. 4989' (Simpson) "

9/26

TD 5071'. Ran Halliburton Elec. Log.

Log tops: Heeb 3956', Tor. 3971',
Doug 3996', Brn ls 4104', Lans. 4121',
BKC 4446', Chk 4608', Miss 4670',
Khk. 4741', Khk sd 4757', Viola 4807',
Simp. 4958', Arb. 5045'

TD 5072' (Card-Aurora Gasoline)

9/28

5½" @ 4767 w/150 sax. WOC "

10/9

TD 5072'. Frac w/10,000# sd,
and 10,000 gal. oil.

Swab 28 BLO. F/172 BLO thru 12/64"
ck in 12 hrs. (308 bbls to recover)

Gauged 700,000 CFG. CP 1200#.

TP 900#. Flowing load oil.

(Card-Aurora Gasoline)

10/25

Received copy of Halliburton Radiation
Guard Log & Perf. Guns Atlas Radiation
Log. - Given to S.A. Shannon, Wichita
District, Div. Geologist.

10/24

Flowing load + gas Ga/1,500 MCF 3/4"
ck. SI. SITP 1328#. SICP 1330#

1 hr test. in 15". G/6,640 MCF.

Stabil. end of hr. 4,160 MCF. CP 800#

plus 1½ BWPB 2" tbg. open flow
completion 4,100 MCFGPD (Miss Pf 4675-
98) RTD 5071'

10-30 Advised Contract Section Complete. ✓

COMPLETED

Co.

County Kiowa Elev. 2145
 Sec. 17 Twp. 27S Rge. 17W
 Company Aurora Gasoline Co.
 Foreman Campbell No. 1

	DEPTH	LOG	DATUM	Loc. in Sec.
				SE SE SW
H.	3956	3956		DS - E/2 SW
Tr.		3921		
Dg.		3996		
Bl.	4105	4104		
L.	4131	4131		
K.C.				Geol.
B.K.C.	4448	4446		Contr.
Ce. <u>sh</u>	4607	4608		Smitherman
C.				
M.	4669	4670		Pool
M. <u>Kd</u>		4741		Wildcat
K. <u>sd</u>	4758	4757		SDA - FO
Mz.				SDA & Amerada
Me.				DM
V.	4799	4807		Ted Gore DM
S.		4958		COMPLETE
S.				OCT 24 '56
A.		5045		
R.				
Pe.				
G.				
T.D.	5071	5072		

Loc.

No.

Sec.

T.

R.

Date Comm. Arb. testLoc. SEP 5 '56

SEP 12 '56

RURSPD9-10-56 85/8 382/400 D 2400

SEP 20 '56

SEP 19 '56

✓ DST 4268-86 op 1 hr rec. 45'M. wts FP 45-60 BHP 1500BKC 4448 CC sh 4607 MISS 4669✓ DST 4654-95 op 1 hr 9 1/5" ga l. 200MCF ga l. 250 MCF/28" 1,200 MCFLAST 30" rec. 360' GCM FP 245-300

BHP 1290 DST 4698-4730 or 1 hr
 6/36" ga 44 MCF rec 95' COM
 FP 50-60 134P 1545 FBHP
 1565 Kd sd 4758 Vio. 4799?
 18 4989 OCT 3 '56 X RTD 5071
 Ran log Tops. $\sqrt{5\frac{1}{2}}$ @ 4767/150
 MCT OCT 10 '56 X CO 64/4675
 -91 16/4694-98 ga. 850 MCF
 FRAC 10 X 10 Flwg Ld + 700
 MCF 12/64" ch CP 1200 #
 TP 900 # OCT 17 '56 X $\sqrt{\text{Flwg Ld +}}$
 900 ga 1,500 MCF $\frac{3}{4}$ " ch. S.I.
 OCT 24 '56 X SITP 1328# SICP 1330#
 1 hr tst in 15" ga 6,640
 MCF stabil. end. of hr 4,160
 MCF CP 800# + $\frac{1}{2}$ BWph 2"
 Tbg. or Flow completion
 4,100 MCF LPP
 (Miss PF. 4675 - 98)
 RTD 5071

465

FORM 513 SUNRAY

County Kiowa Elev. _____
 Sec. 17 Twp. 27S Rge. 17W
 Company Aurora Gasoline Co.
 Farm Name Campbell No. 1

TOPS	DEPTH	LOG	DATUM	Loc. in Sec.
Anh.				SE SE SW
T.P.				DS - E/2 SW
H.				
Tr.				
Dg.				
BL.				
L.				Geol.
K.C.				Contr.
B.K.C.				Smitherman
Ce.				
C.				Pool
M.				Wildcat
M.				SDM - FO
K.				SDX & Amerada
Mz.				DHM
Ma.				Ted Gore DHM
V.				FIRST REPORT
S.				AUG 29 56
S.				
A.				
R.				
Pe.				
G.				
T.D.				

Date Comm. Arb. test

(TWH6-DC7)

Loc.

SEP 4 1956

M.M.