


Section 17 Township 27 Range 38W

Well No. #1 ~~Hickok~~ WADIE

Company Stanolind

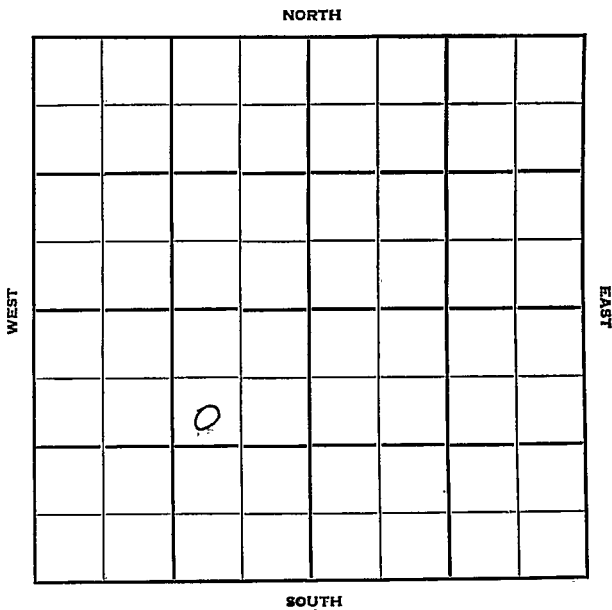

Grant

KANSAS

Sec. 17 Twp. 27 R. 38W

Well No. #1 ^{Waldie} Hickok Farm

Stanolind Company

Contractor

Hugoton Pool


1250' Ft. from N. Line

_____ Ft. from S. Line

1250' Ft. from E. Line

_____ Ft. from W. Line

SW NE SW

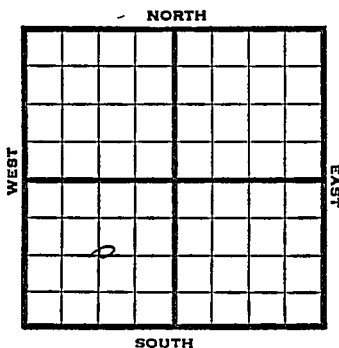

1951

Elev. 3120' REPORT

10/24
12/12

Location
 Spud 10-24-51
 Gas Well TD 2563
 10" @ 124 8" @ 800
 Her. 2331 Win. 2401 Tow. 2450
 Ft. Riley 2499
 5" @ 2500 TD 2563 90/ 2331-46
 24/ 2350-54 24/ 2357-61
 18/ 2404-07 54/ 2411-20
 24/ 2430-34 30/ 2440-45
 3 30/ 2466-71 72/ 2475-87
 24/ 2492-96 21000 A
 Comp. 5,384,000 gas 385#

COMPLETED

Kansas

Map No. _____ Sec. 17 Twp. 27 R. 38W

Well No. 1 Waldie

Stanolind Company

SW NE SW ~~CORRECTION~~ Contractor

SECTION PLAT

1250 Ft. from N. Line

_____ Ft. from S. Line

1250 Ft. from E. Line

_____ Ft. from W. Line

	o		

Grant County

RECORD

Location _____

Rig up _____

Drilling and Remarks:

Reported
#1 Hickok

Cased _____ in., _____ ft.

Sand _____

Gas _____

Oil _____

Total Depth _____

PRODUCTION

1st 24 hrs. Nat. _____

1st 24 hrs. after shot _____

Gas _____ Cu. Ft.

Dry Hole _____

Abandoned _____

Date

NOV 14 1951

19

J. E. TYRA

Scout

