


Kingman

KANSAS

Section 17 Township 27 Range 5W

Well No. #1 Evans

Company Westgate-Greenland

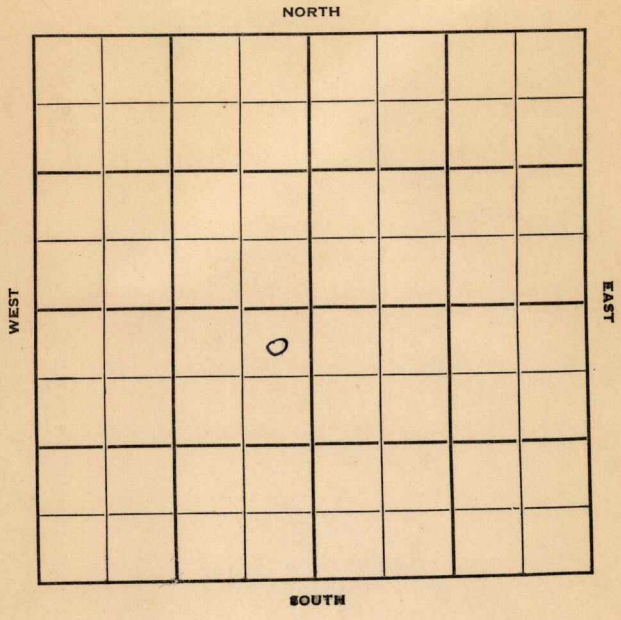

KANSAS

Kingman

Sec. 17 Twp. 27 R. 5-W ✓

Well No. #1 Evans Farm

Westgate-Greenland Company

Jackson Drlg. Contractor

Wildcat

330 Ft. from N. Line


 Ft. from S. Line

330 Ft. from E. Line

 Ft. from W. Line

NE NE SW

Magnolia farmout

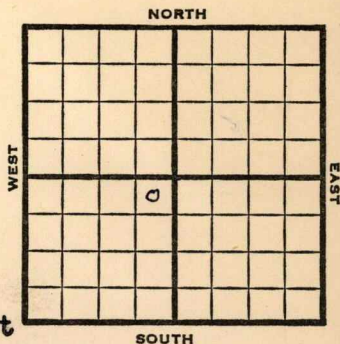

1950 **Elev 1497** REPORT

10/18 Spud 10-12-50

8" @ 203

drlg 2545

11/1 8" @ 203

Miss 3749

Viola 4125

Simp 4195

DST 4203-19 opn 1 hr rec 120' water

Arb 4208

TD 4305

D&A

ABANDONED

County Kingman State Kansas
 Sec. 17 (Blk.) 27 (Sur.) 5W Map No.
 Operator Westgate-Greenland
 Well No. 1 Farm Evans
 Elev. Location NE NE SW



330 Ft. From N Line SW
330 Ft. From E Line Quarter

1st. Report OCT 18 1950

Completion

Remarks Magnolia farmout
Jackson Drlg. - Contr.

Spudding Date 10-12-50


Drlg. Data

Wildcat

8" @ 203 drlg. 2545

J. E. TYRA

County Kingman State Kansas
 Sec. 17 (Blk. 27) (Sur. 5W) (Twsp. Map No.)
 Operator Westgate-Greenland
 Well No. 1 Farm Evans
 Elev. 1497 Location NE NE SW

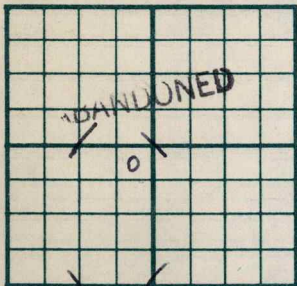

330 Ft. From N Line SW
330 Ft. From E Line Quarter
 1st. Report
 Completion NOV 1 1950
 Remarks Wildcat
Jackson Drlg. - Contr.
 Spudding Date 10-12-50

Drlg. Data D & A TD 4305
8" @ 203 Miss. 3749 Viola 4125
Simp. 4195 DST 4203-19 open 1 hr.
Rec. 120' water Arb. 4208 TD 4305

D & A

J. E. TYRA