

KANSAS

Kiowa

FORM 51 5M PETROL

Section 2 Township 27 Range 18-W

Well No. #1 W. C. Mitchell

Company Texas

NORTH

						0	

SOUTH

WEST

EAST

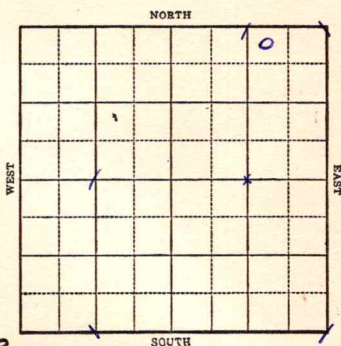
KANSAS

Kiowa

Sec. 2 Twp. 27 R. 18-WWell No. #1 W. C. Mitchell Farm

Texas

Company

330 Ft. from N. Line Ft. from S. Line990 Ft. from E. Line Ft. from W. LineElev. 2168

1943

R E P O R T

10/27 Location

11/3 Derrick

11/10 324 Run Csg.

11/17 13" @ 324'

Drlg. 2656'

11/24 Drlg 3930'

12/1 3930 fsg

12/8 "

12-15 "

12/22 "

12/29 "

1944

1-5 PB 3655 Whipstock

1-12 Oread 3970

Drlg 4036'

1/19 Lans 4094

Drlg. 4344

1/26 Cong 4626

Kind 4638

Sand 4646-54 S dead oil

Drlg. 4663'

2/2 Viola 4761

Arb 5022

Drlg. 5050

No shows.

OVER

1944

2/8 TD 5058:1 per hr 24 hrs.

5" @ 5057

Rust

2/15 "

2/23 12 shots 5045-56-7 water $\frac{1}{2}$ er jr/

3/1 5" @ 5057

Arb 50223

TD 5058:603

Water 5022

Arb 5036

TD 5058

ABANDONED

KANSAS

Map No. 91 Sec. 2 Twp. 27 R. 18WWell No. 1 W. C. MitchellTexas

Company

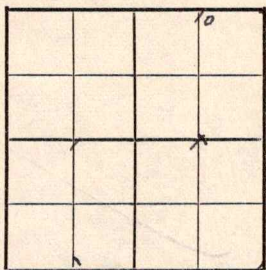
FIRST REPORT

Contractor

NW NE NE

330 Ft. from N. Line Ft. from S. Line990 Ft. from E. Line Ft. from W. Line

SECTION PLAT



Wildcat

Location XRig up

Drilling and Remarks:

RECORD

Cased in., ft.Sand Gas Oil Total Depth

PRODUCTION

1st 24 hrs. Nat. 1st 24 hrs. after shot Gas Cu. Ft.Dry Hole Abandoned

Date

OCT 27 1943

19

S. J. LEWIS

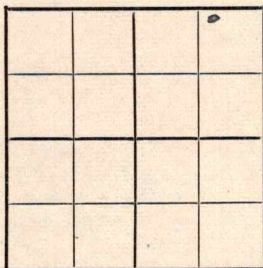
Scout

KANSAS
Map No. 97 Sec. 2 Twp. 27 R. 18W

Well No. 1 W. C. MitchellTexas CompanyABANDONED Contractor

NW NE NE

SECTION PLAT

330 Ft. from N. Line Ft. from S. Line990 Ft. from E. Line Ft. from W. LineWildcatLocation Rig up

Drilling and Remarks:

Cur 450 22.5' @ 5057Water

RECORD

Cased in., ft.Sand Gas Oil Total Depth 5058

PRODUCTION

1st 24 hrs. Nat. 1st 24 hrs. after shot Gas Cu. Ft.Dry Hole Abandoned

Date

MAR 1 1944 19S. J. LEWIS Scout