

KANSAS

Grant county


Sec. 18 Twp. 27 R. 35W

Well No. 1 Forte Farm
Columbian Fuel Company

Hugoton Pool

NORTH

330 Ft. from N. Line

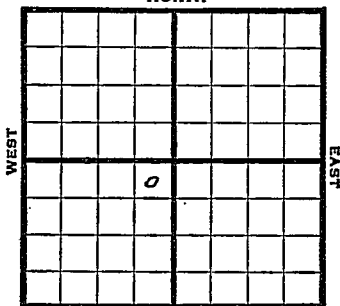

Ft. from S. Line

330

Ft. from E. Line

Ft. from W. Line

NE SW

SOUTH

1947 Elev 3093' REPORT

5/7 RUR
5/13 10" @ 520'
Drlg 2450'
5/20 TD 2585'
5" @ 2575'
RUST
5/27 " "
6/3 TD 2792-221' of 5"
Perf liner @ 2792'
6/10 18000 Acid.
6/17 "
6/25 TD 2792'
7" @ 2575'
221' of 5" Perf lines @ 2792
18000 acid
11,696,000 Gas
425# R. Pr.
Complete

COMPLETED.

Map No. _____ Sec. 18 Twp. 27 R. 35W

Well No. 1 Forte

Columbian Fuel Company

FIRST REPORT

Contractor _____

NE SW

SECTION PLAT

330 Ft. from N. Line

_____ Ft. from S. Line

330 Ft. from E. Line

_____ Ft. from W. Line

Grant County

Location _____

Rig up _____

Drilling and Remarks:

R U R

RECORD

Cased _____ in, _____ ft.

Sand _____

Gas _____

Oil _____

Total Depth _____

PRODUCTION

1st 24 hrs. Nat. _____

1st 24 hrs. after shot _____

Gas _____ Cu. Ft.

Dry Hole _____

Abandoned _____

Date

MAY 7 1947 19

S. J. LEWIS Scout

Map No. 0 Sec. 18 Twp. 27 R. 35W

Well No. 1 Forte

Columbian Fuel Company

COMPLETE

Contractor

NE SW

E. 1. 2023

SECTION PLAT

330 Ft. from N. Line

 Ft. from S. Line

330 Ft. from E. Line

 Ft. from W. Line

	4		

Grant County

Location

Rig up

Drilling and Remarks:

7" @ 2375
221' of 5" Perf line @ 2792
18000 cu ft
11,696,000 Gall
425# R/A

RECORD

Cased in., ft.

Sand

Gas

Oil

Total Depth 2792

PRODUCTION

1st 24 hrs. Nat.

1st 24 hrs. after shot

Gas Cu. Ft.

Dry Hole

Abandoned

Date

JUN 25 1947 19

S. J. LEWIS Scout