

Section 18 Township 27 Range 39 WWell No. # 1 Hull "B"Company Stanolind

				0			

NORTH

WEST

EAST

SOUTH

Stanton

FORM 252-B

KANSAS


Sec. 18 Twp. 27 R. 39WWell No. #1 Hull "B" FarmStanolind Company

Contractor

Hugoton Pool

300 Ft. from N. Line Ft. from S. Line Ft. from E. Line300 Ft. from W. Line

NW NW SE

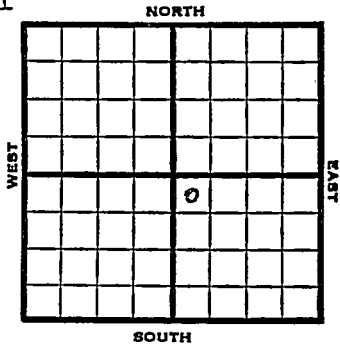

1953

Elev. 3188' REPORT

6/3

Spud 5-28-53
 8" @ 606'
 WOC

6/10

RTD 2450' 5" @ 2427 CO 2450 NS
 2500 A 6 M gas. Her 2253 Win 2304
 Up Ft. ~~24~~ 2380' Low Ft. 2427

6/24


Spud 5-28-53
 Gas Well
 TD 2450'
 8" @ 606
 TD 2450
 5" @ 2427
 CO to 2450
 2500A
 Her 2253, Win 2304, Ft Riley 2380
 48/2258-66, 24/2270-74, 12/2277-79,
 12/2282-84, 12/2286-88, 42/2292-99,
 72/2310-22, 24/2326-30, 24/2335-39,
 24/2348-52, 42/2370-77, 36/2382-88,
 18/2393-96, 12/2401-03, 24/2406-10,
 12/2413-15, 25000A
 Comp. 2,925,000 gas, 362#

COMPLETED

87 @ 606 WOC

J. G. McGEHEE

County Stanton State Kansas
 Sec. 18 (Blk. 27 (Sur. 39W Map No.
 (Twp.) (Rge.)
 Operator Stanolind
 Well No. 1 Farm Hull "B"
 Elev. 3188 Location NW NW SE

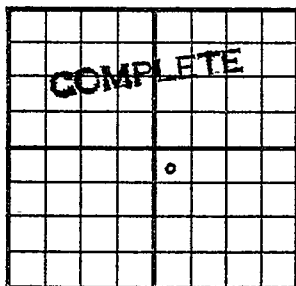

300 Ft. From N Line SE
300 Ft. From W Line Quarter
 1st. Report
 Completion JUN 24 1953
 Remarks Hugoton Pool
 Spudding Date 5-28-53

Drlg. Data Gas well TD 2450
8" @ 606 TD 2450 5" @ 2427 CO to 2450
2500 A Her. 2253 Win. 2304
Ft. Riley 2380 48/ 2258-66 24/ 2270-74
12/ 2277-79 12/ 2282-84 12/ 2286-88
42/ 2292-99 72/ 2310-22 24/ 2326-30
24/ 2335-39 24/ 2348-52 42/ 2370-77
36/ 2382-88 18/ 2393-96 12/ 2401-03
24/ 2406-10 12/ 2413-15 25000 A
Comp. 2,925,000 gas 362#

J. G. McGEHEE