


Section 18 Township 27 Range 12 W

Well No. # 2 Brown

Company Skelly Oil

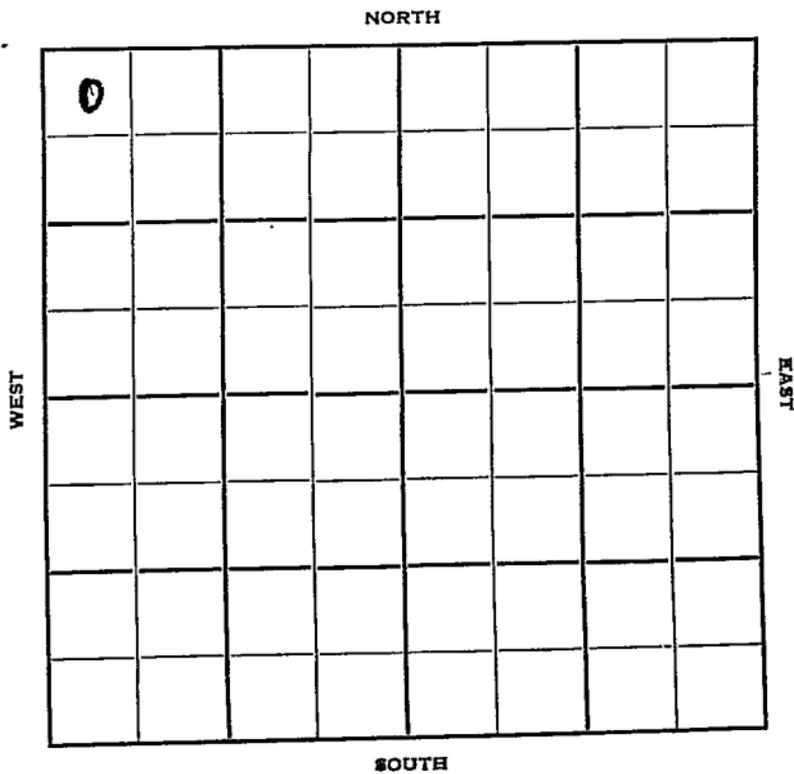

Sec. 18 Twp. 27 R. 12 W

Well No. # 2 Brown Farm

Skelly Oil Company

Contractor


330 Ft. from N. Line

_____ Ft. from S. Line

_____ Ft. from E. Line

330 Ft. from W. Line

NW NW NW

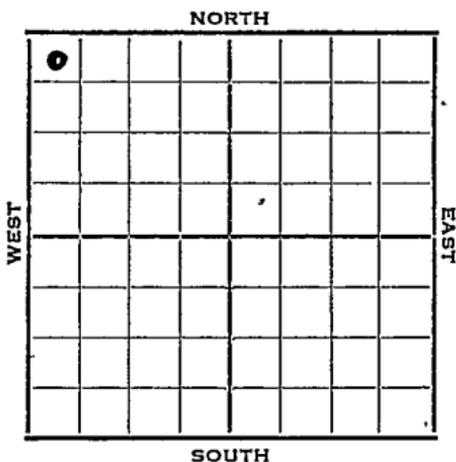

1952	Elev. 1866' REPORT
11/26	Location
12/4	8" @ 450 Drlg. 3230'
12/11	Br 1 3679 Lans 3697 Miss 4146 V 4181 Simp 4227 Ø4250
12/18	RTD 4306 5" @ 4306
12/25	" " "
12/30	Spud 11-22-52 Oil well TD 4306'
	8" @ 450 Br. line-3679'
	Lans. 3697' Miss 4146' Biola 4181'
	Simp. 4227' TD 4306 5" @ 4306
	CO to 4301 84/4269-81 F/178 BO 5 hr.
	D-hydro. F/240 BO 10 hr.
	Comp. 3000 BOPD
	COMPLETED

County Pratt State Kansas

Sec. 18 (Blk. Twp.) 27 (Sur. Rge.) 12W Map No.

Operator Skelly Oil

Well No. 2 Farm Brown

Elev. 1866 Location NW NW NW

0					
COMPLETE					

330 Ft. From N Line NW

330 Ft. From W Line Quarter

1st. Report

Completion DFC 30 1952

Remarks

Spudding Date 11-22-52

Drlg. Data Oil well TD 4306

8" @ 450 Br. lime 3679 Lans. 3697

Miss. 4146 Viola 4181 Simp. 4227

TD 4306 5" @ 4306 CO to 4301

84/ 4269-81 F/ 178 bo 5 hr. D-hydro.

F/ 240 bo 10 hr.

Comp. 3000 bopd

J. G. McGEHEE