
FORM 51 25M 8-50 WESTERN Pratt KANSAS

Section 18 Township 27 Range 12W

Well No. #1 J. E. Brown

Company Skelly

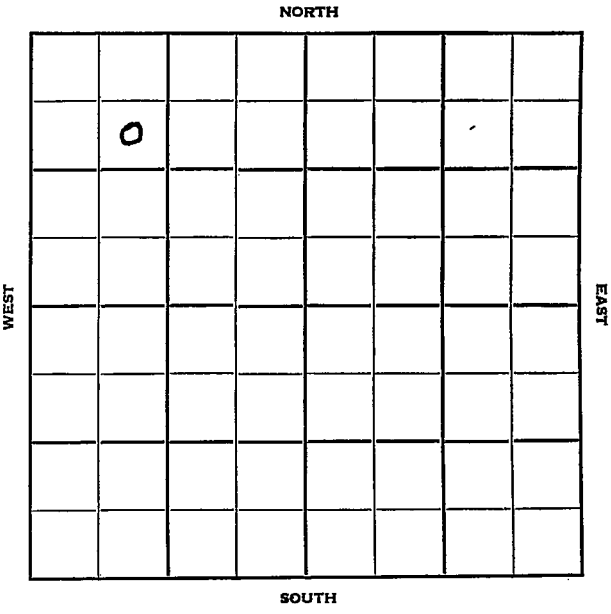

FORM 252-B
10M 10-50 PETROL

Pratt KANSAS

Sec. 18 Twp. 27 R. 12 W

Well No. # 1 J. E. Brown Farm

Skelly Company

Contractor


990 Ft. from N. Line

Ft. from S. Line

Ft. from E. Line

990 Ft. from W. Line

SE NW NW

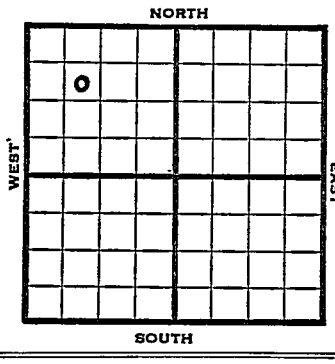

1952	Elev. 1878' REPORT
8/13	Location
8/20	8" @ 439 Drlg. 2400
8/27	Drlg. 3772'
9/3	Br Li 3683 Lans. 3703 Miss Li 4165 V 4197 Simp Sh 4238 Simp sd 4265 RTD 4324 5" @ 4324
9/10	12/4318-21 fill up 1000' wtr 1½ hr. Sq off
9/17	PB 4313 16/ 4306-10 56/ 4296-4310 F 180 BO 8 hrs. D-Hyd. F 379 BO & 214 BW 18 hrs. sq. off.
9/24	12/4302-06 1/2 BO & 1/2 BWPH Sq off
10/1	CO 4310 29/ 4299-4302 15 gals & 7 galwph 16/ 4295-99 PB 4286 24/ 4278-82 40/ 4268-78 F 75 BO 2½ hrs. D-Hyd F 23/64" CK 383 BO 13 hrs.
10/8	Spud 8-12-52 Oil well TD 4324' 8" @ 439 Br. lime 3683' Lans. 3703' Miss 4165' Viola 4197' Simp. sh. 4238' Simp. dol. 4246' Simp sd 4265'

OVER

1952
10/8

(Information continued)
TD 4324' 5" @ 4324' .12/4318-21
FU 1000' wtr. 1½ hr. PB 4313'
16/4306-10 56/4296-4310'
F/180 BO 8 hr. D-hydro. F/379 BO
214 BW 13 hr. 12/4302-06 ½ BO
½ BWPH CO to 4310' 20/4299-4302
15 GO 7 GWPH 16/4295-99 B/20 GO
7 GWPH PB 4286 24/4278-82
40/4268-78 F/175 BO 2 hr. D-hydro.
F/383 BO 13 hr.
Comp. 3000 BOPD

COMPLETED

FORM 275 FOR SALE BY KANSAS BLUE PRINT CO.


County Pratt State Kansas

Sec. 18 (Blk. Twp.) 27 (Sur. Rge.) 12W Map No.

Operator Skelly

Well No. 1 Farm J. E. Brown

Elev. Location SE NW NW

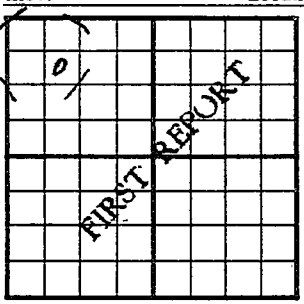

990 Ft. From N Line NW

990 Ft. From W Line Quarter

1st. Report AUG 13 1952

Completion

Remarks

Spudding Date

Drlg. Data

Location

J. G. McGEHEE

AUG 15 1952

Scout Cards	MM
Land Small Map	
Land Wall Map	GP
Tracings	
France Map	
Pierce Map	
Misc.	

Drlg. Data

FORM 275 FOR SALE BY KANSAS BLUE PRINT CO.


County Pratt State Kansas

Sec. 18 (Blk. Twp.) 27 (Sur. Rge.) 12W Map No.

Operator Skelly Oil

Well No. 1 Farm J. E. Brown

Elev. 1878 Location SE NW NW

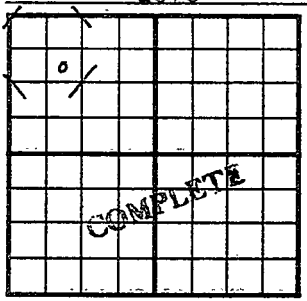

990 Ft. From N Line NW

990 Ft. From W Line Quarter

1st. Report

Completion OCT 8 1952

Remarks

Spudding Date 8-12-52

Drlg. Data Oil well TD 4324

8" @ 439 Br. lime 3683 Lans. 3703

Miss. 4165 Viola 4197 Simp. sh. 4238

Simpl dol. 4246 Simp. sd. 4265 TD 4324

5" @ 4324 12/ 4318-21 FU 1000' wtr. 1½hr

PB 4313 16/ 4306-10 56/ 4296-4310

F/ 180 bo 8 hr. D-hydro. F/ 379 bo

214 bw 13 hr. 12/ 4302-06 ½ bo ½ bwph

CO to 4310 20/ 4299-4302 15 go 7 gwph

16/ 4295-99 B/ 20 go 7 gwph PB 4286

24/ 4278-82 40/ 4268-78 F/ 175 bo 2 hr.

D-hydro. F/ 383 bo 13 hr.

Comp. 3000 bopd

J. G. McGEHEE

OCT 14 1952

Deed Cards
Land Serial Map
Land Ward Map
Tracings
Patent Map
Plance Map
Misc.

Dtlg. Data